



250 TANCA.

1st Level

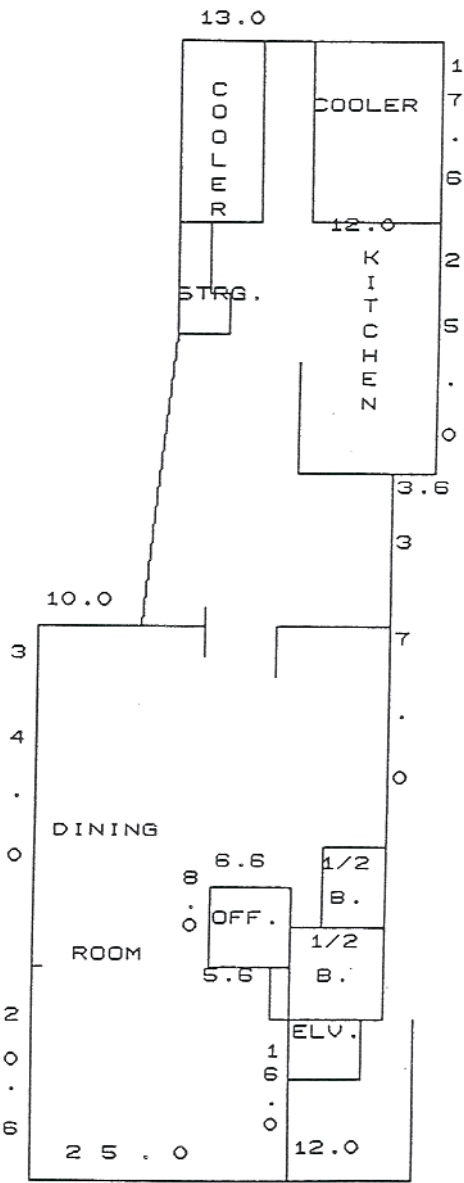



2nd Level

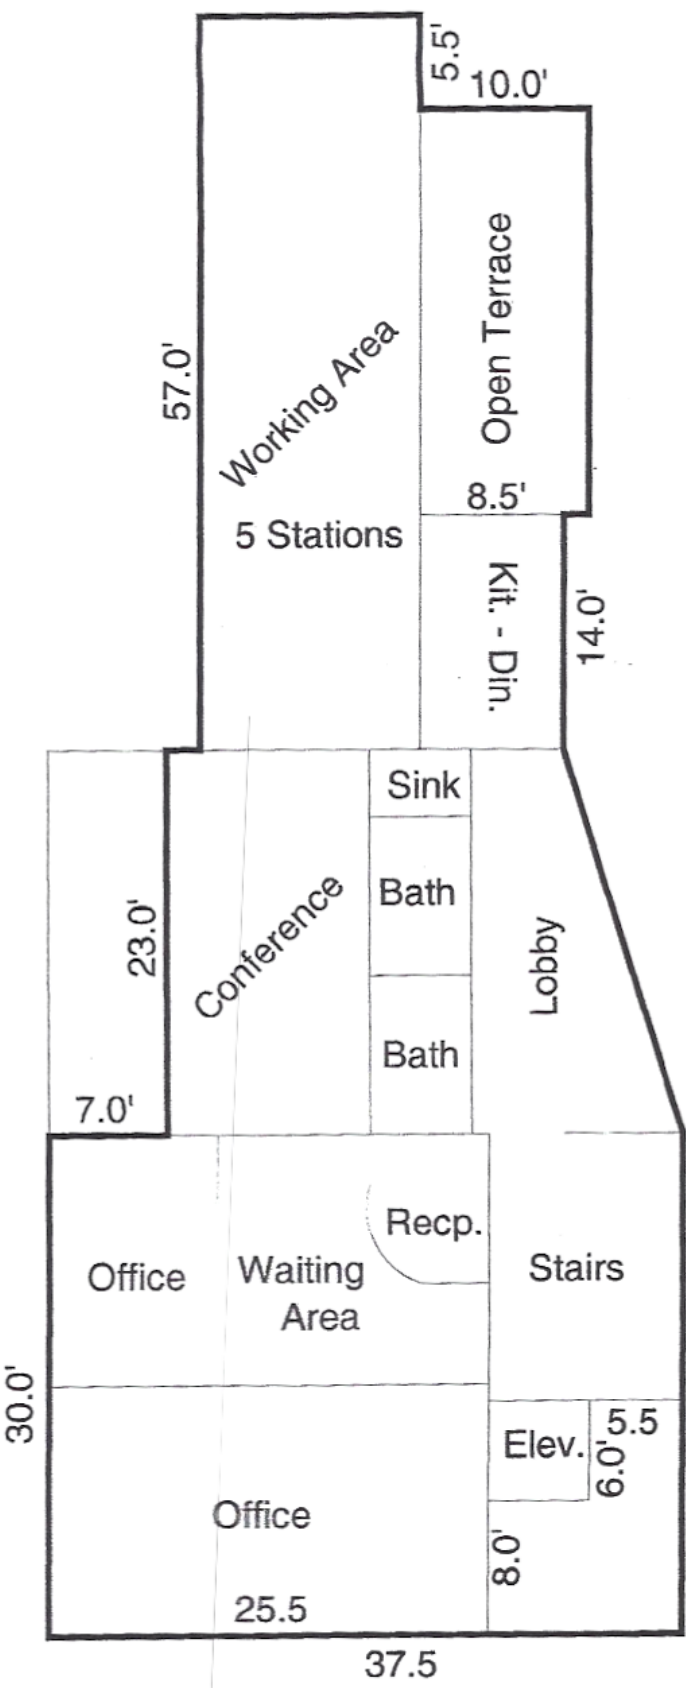

SKETCH/AREA TABLE ADDENDUM


3rd Level

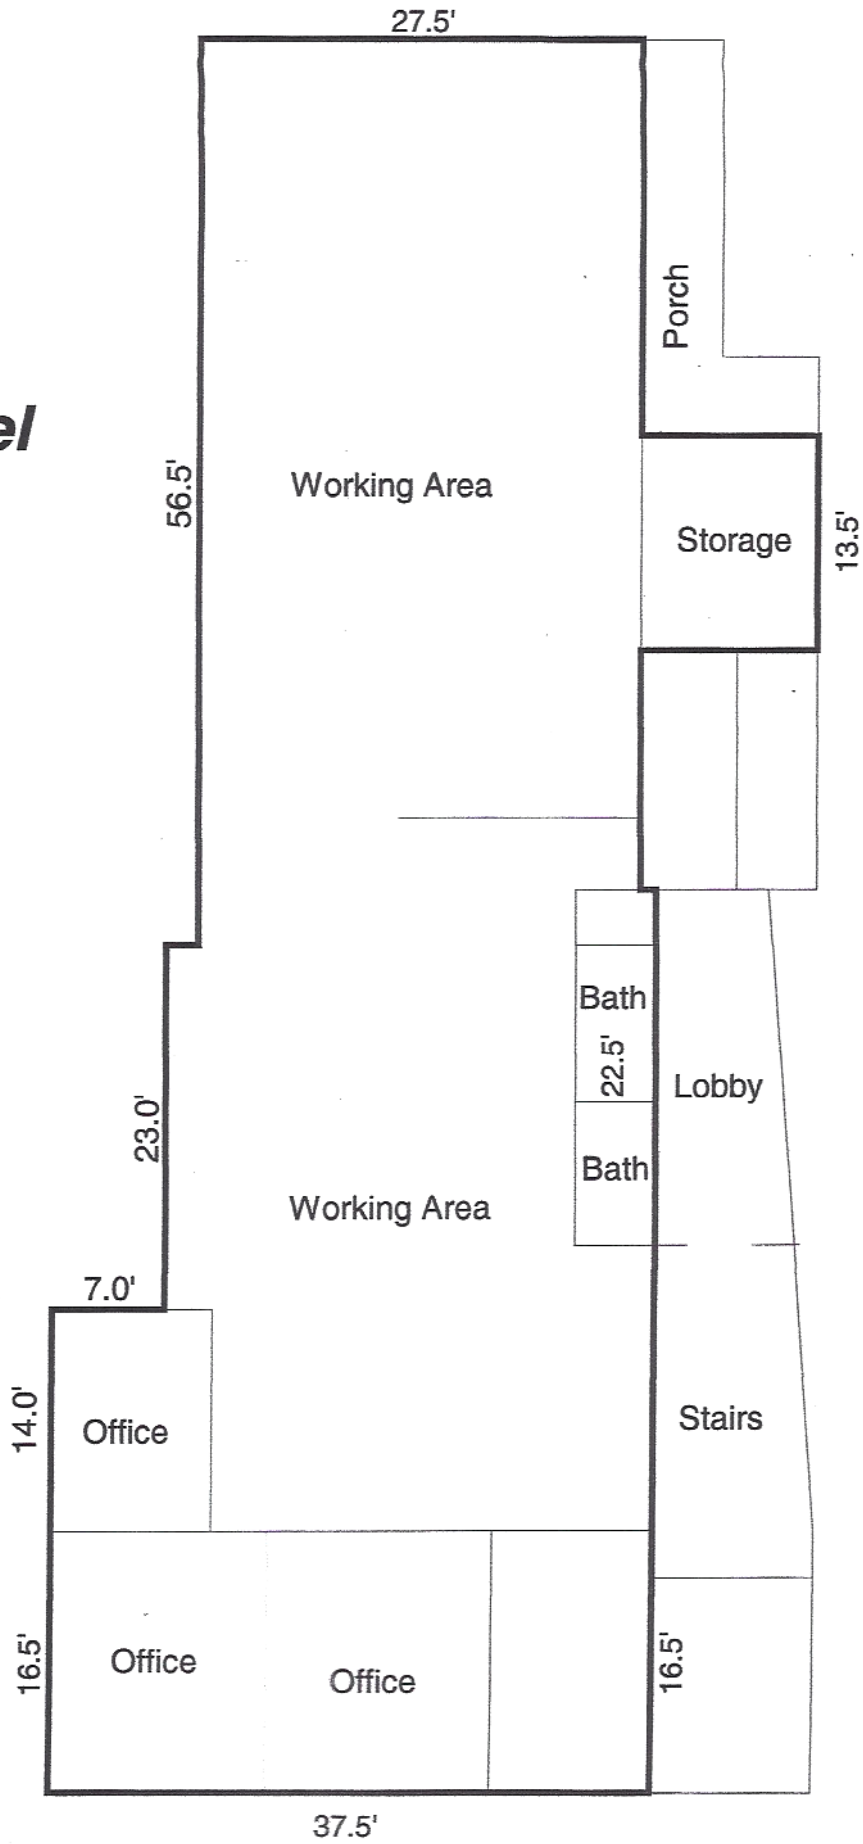

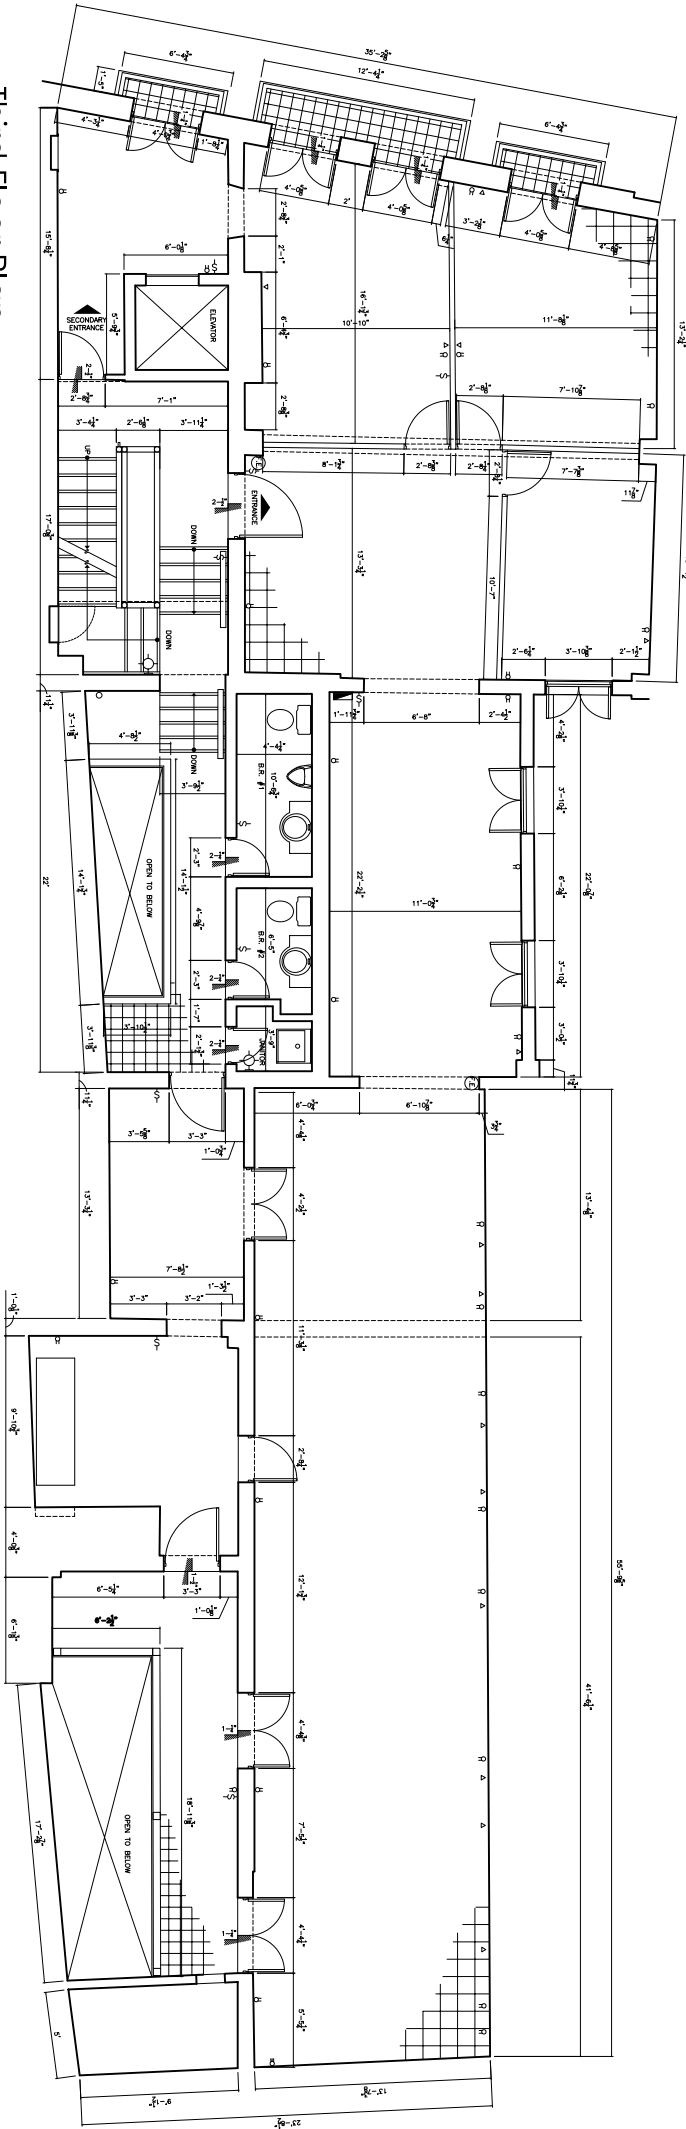

Third Floor Plan

Scale: 1/4"=1'-0"

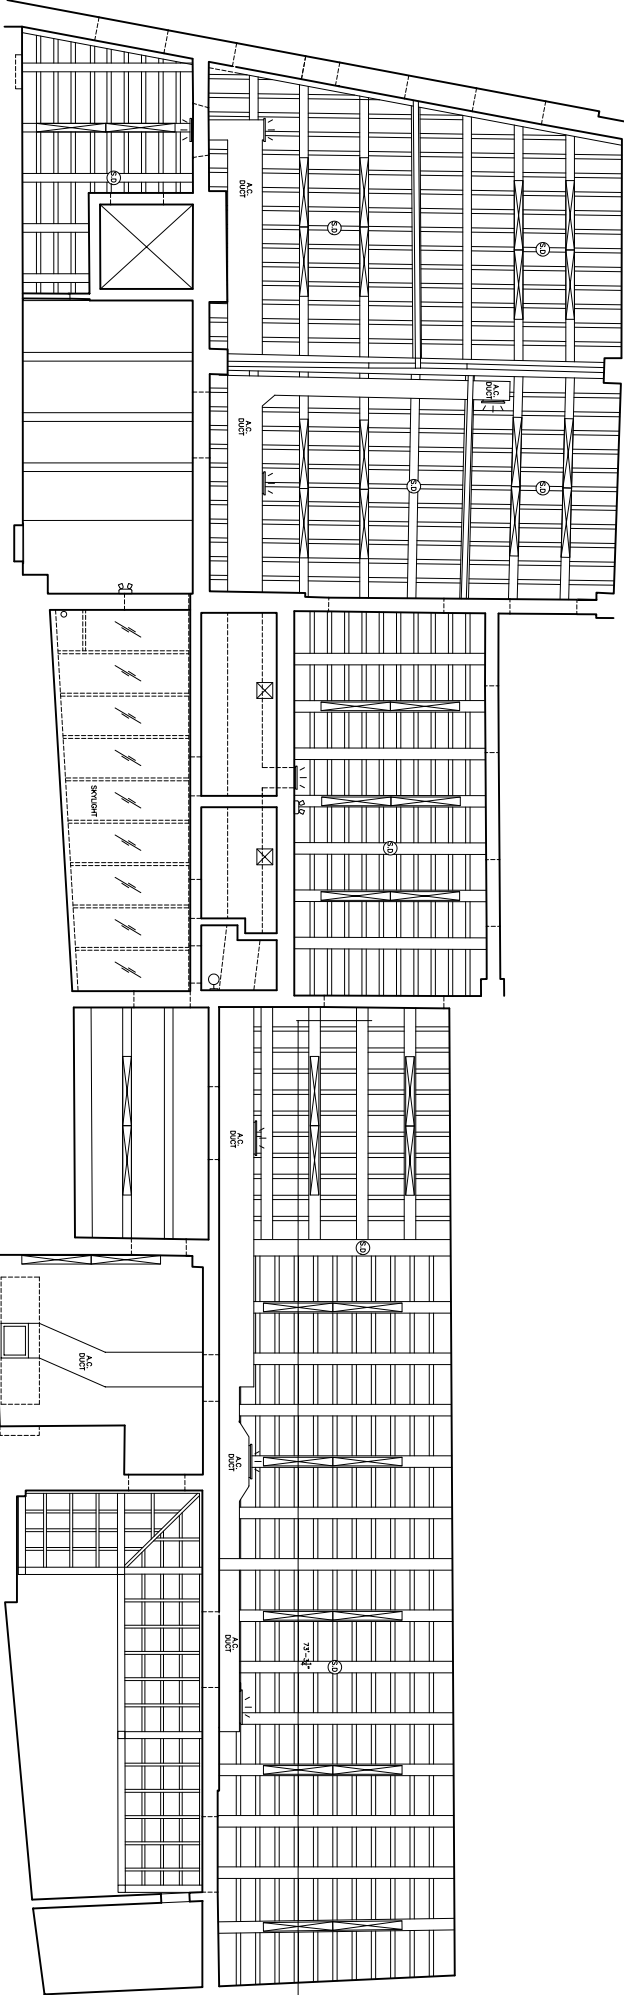

Third Floor Plan
Reflected Ceiling

Scale: 1/4"=1'-0"

OWNER:

Cheiff Medowall

CONSULTANTS

Arch: Ricardo Lugo Esquivel
(787) 326-2727, 7774 Highway 9, Suite 400

PROJECT:

#250 Calle Tanca, Viejo San Juan
As Built Drawings

San Juan, P.R.

REVISIONS

NO. DATE

1	
2	
3	
4	
5	

NOTES / PERMITS

DATE: January 6, 2017

Third Floor
Plan
(As Built)

TOTAL:

A-3