




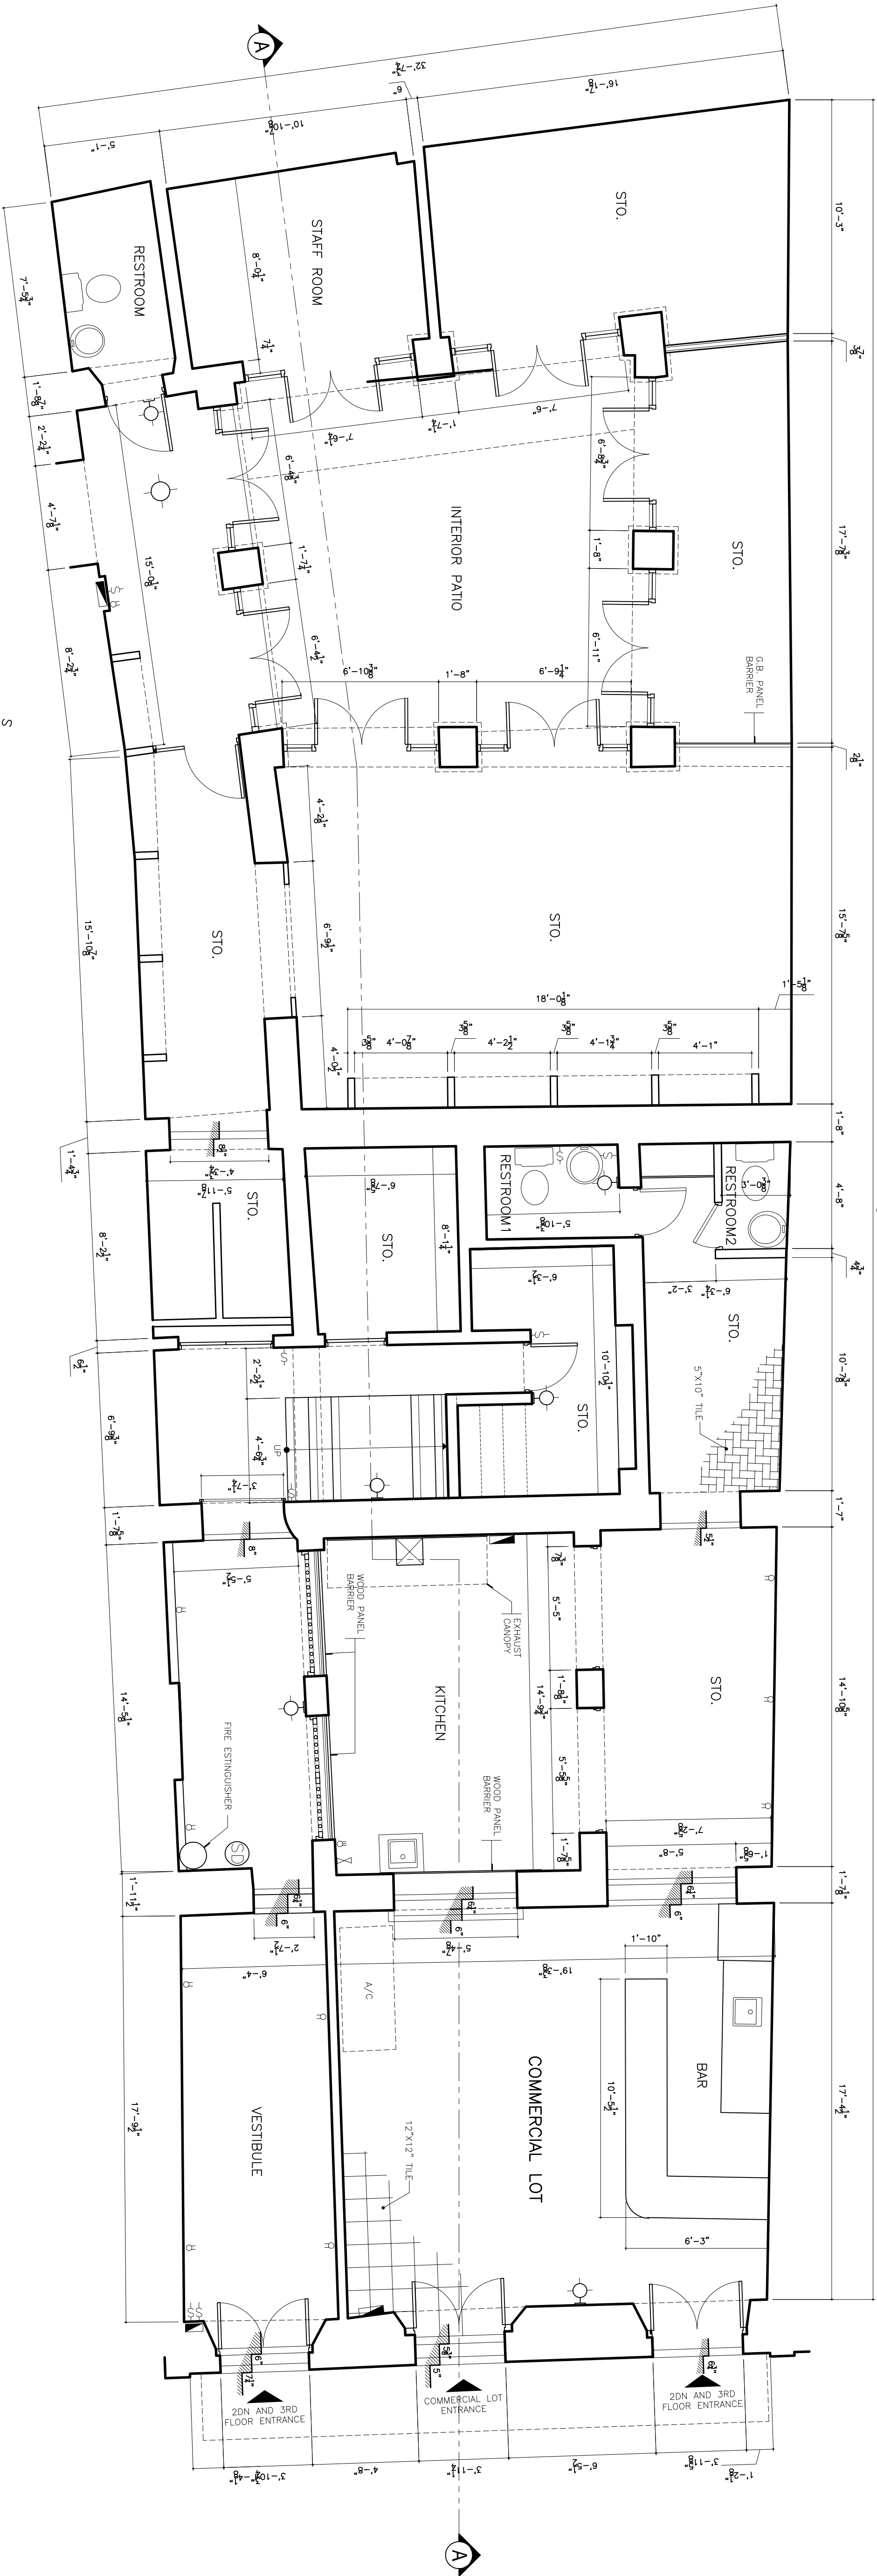

First Floor Plan NET AREA: 2,682 SQ.FT.

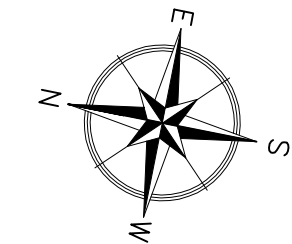

Scale: 1/4"=1'-0"

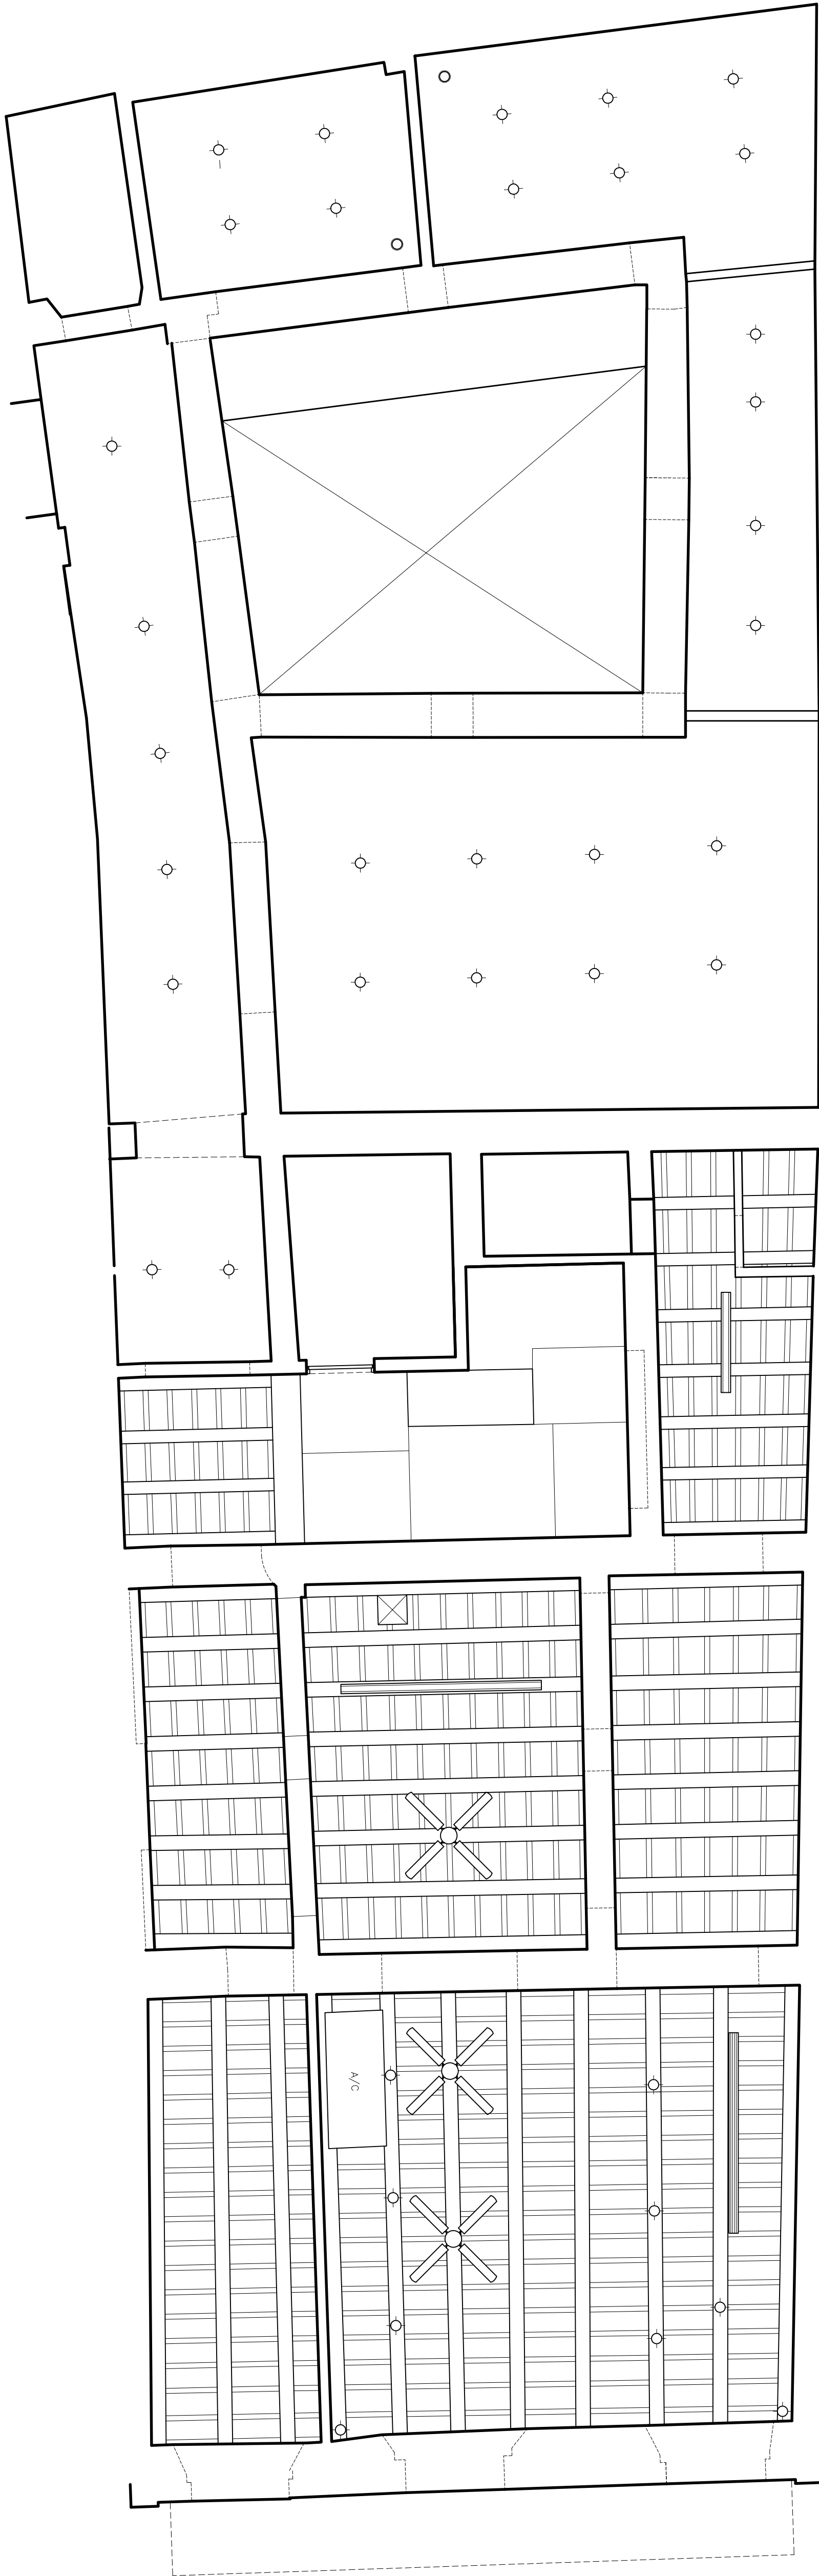

First Floor Plan
Reflected Ceiling

Scale: 1/4"=1'-0"

OWNER:

Cherif Medawar

CONSULTANTS

Aq. Rodonés Lugo Eschimedid

(787) 562-9371 / retnespos@pmo.com

PROJECT:

#251 Del Cristo St., Old San Juan
As Built Drawings
San Juan, P.R.

REVISIONS

NO.	DATE
1	
2	
3	
4	
5	


NOTES / PERMITS

DATE: January 6, 2017

First Floor
Plan & R.
Ceiling
(As Built)


HOJA:

A-1

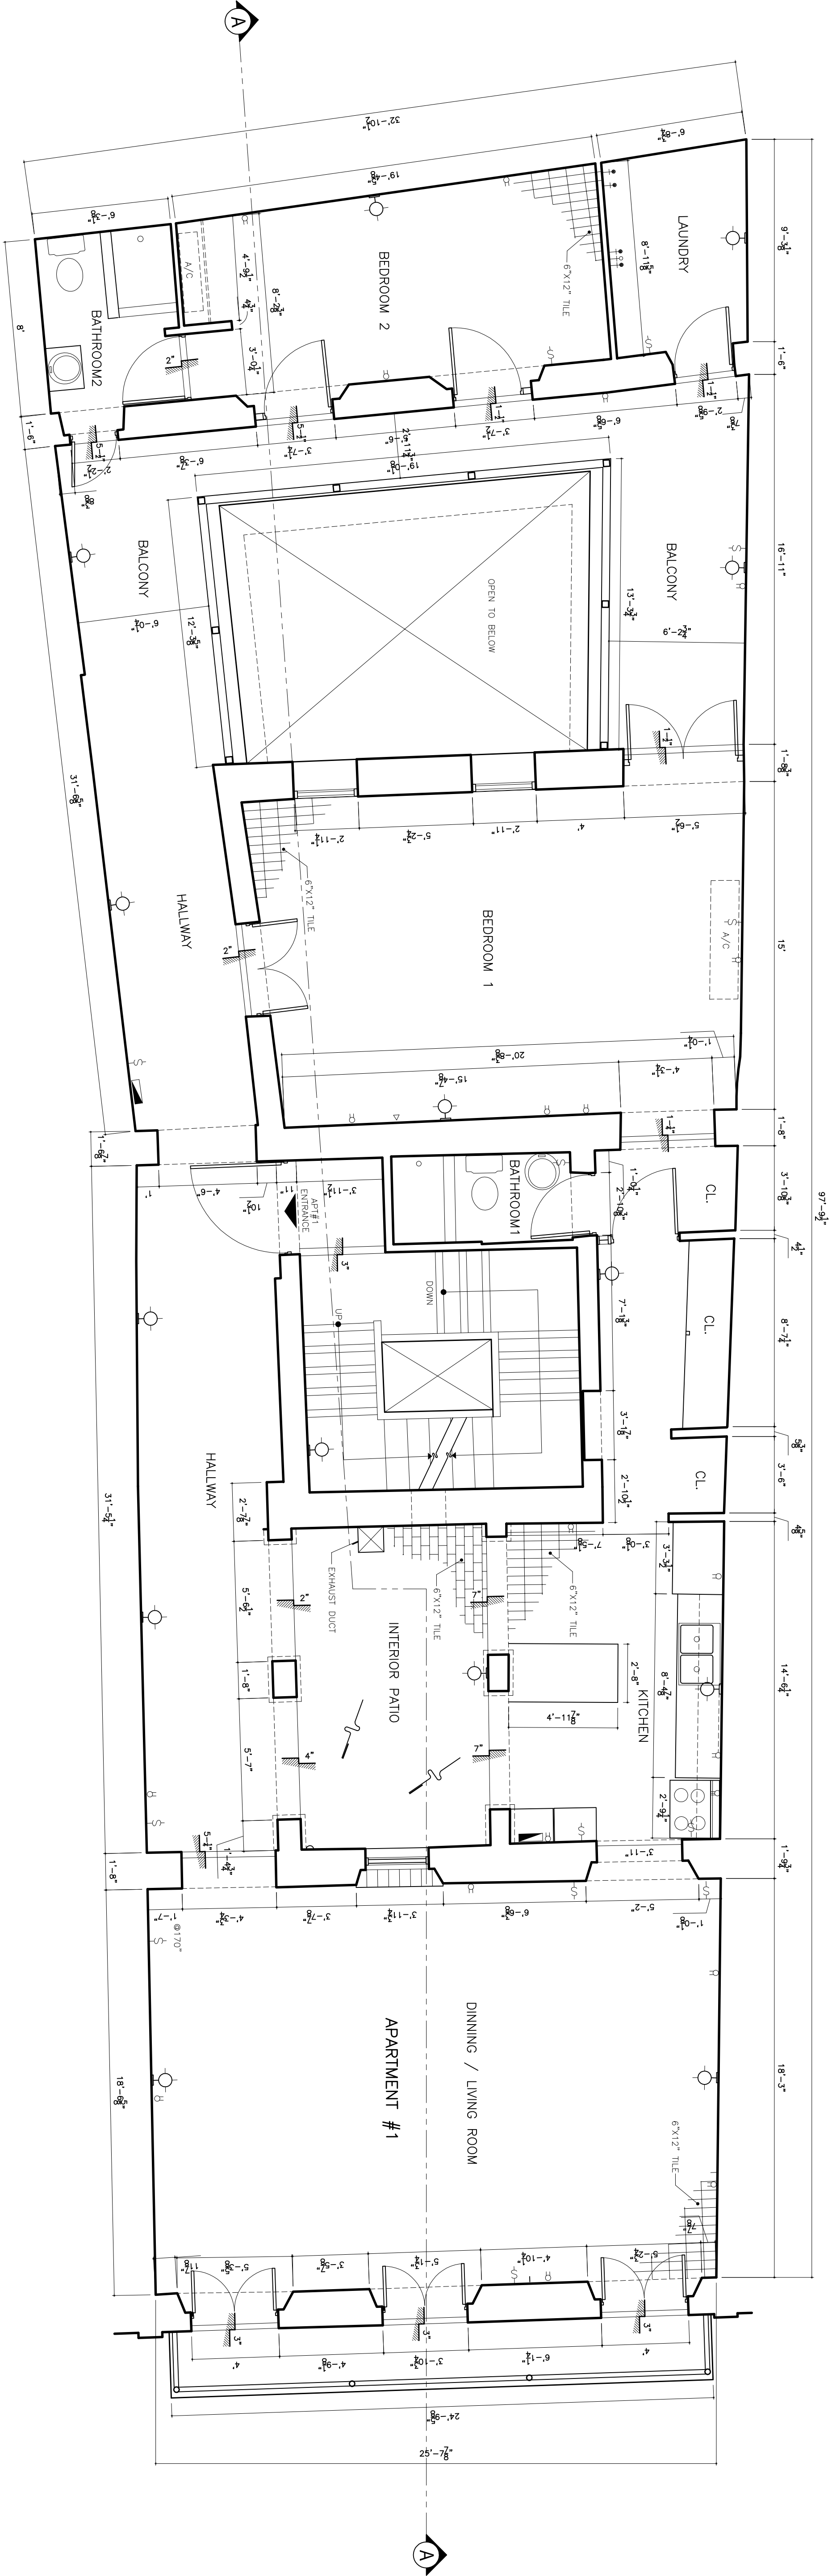

Second Floor Plan NET AREA: 2,620 SQ.FT.

Scale: 1/4"=1'-0"

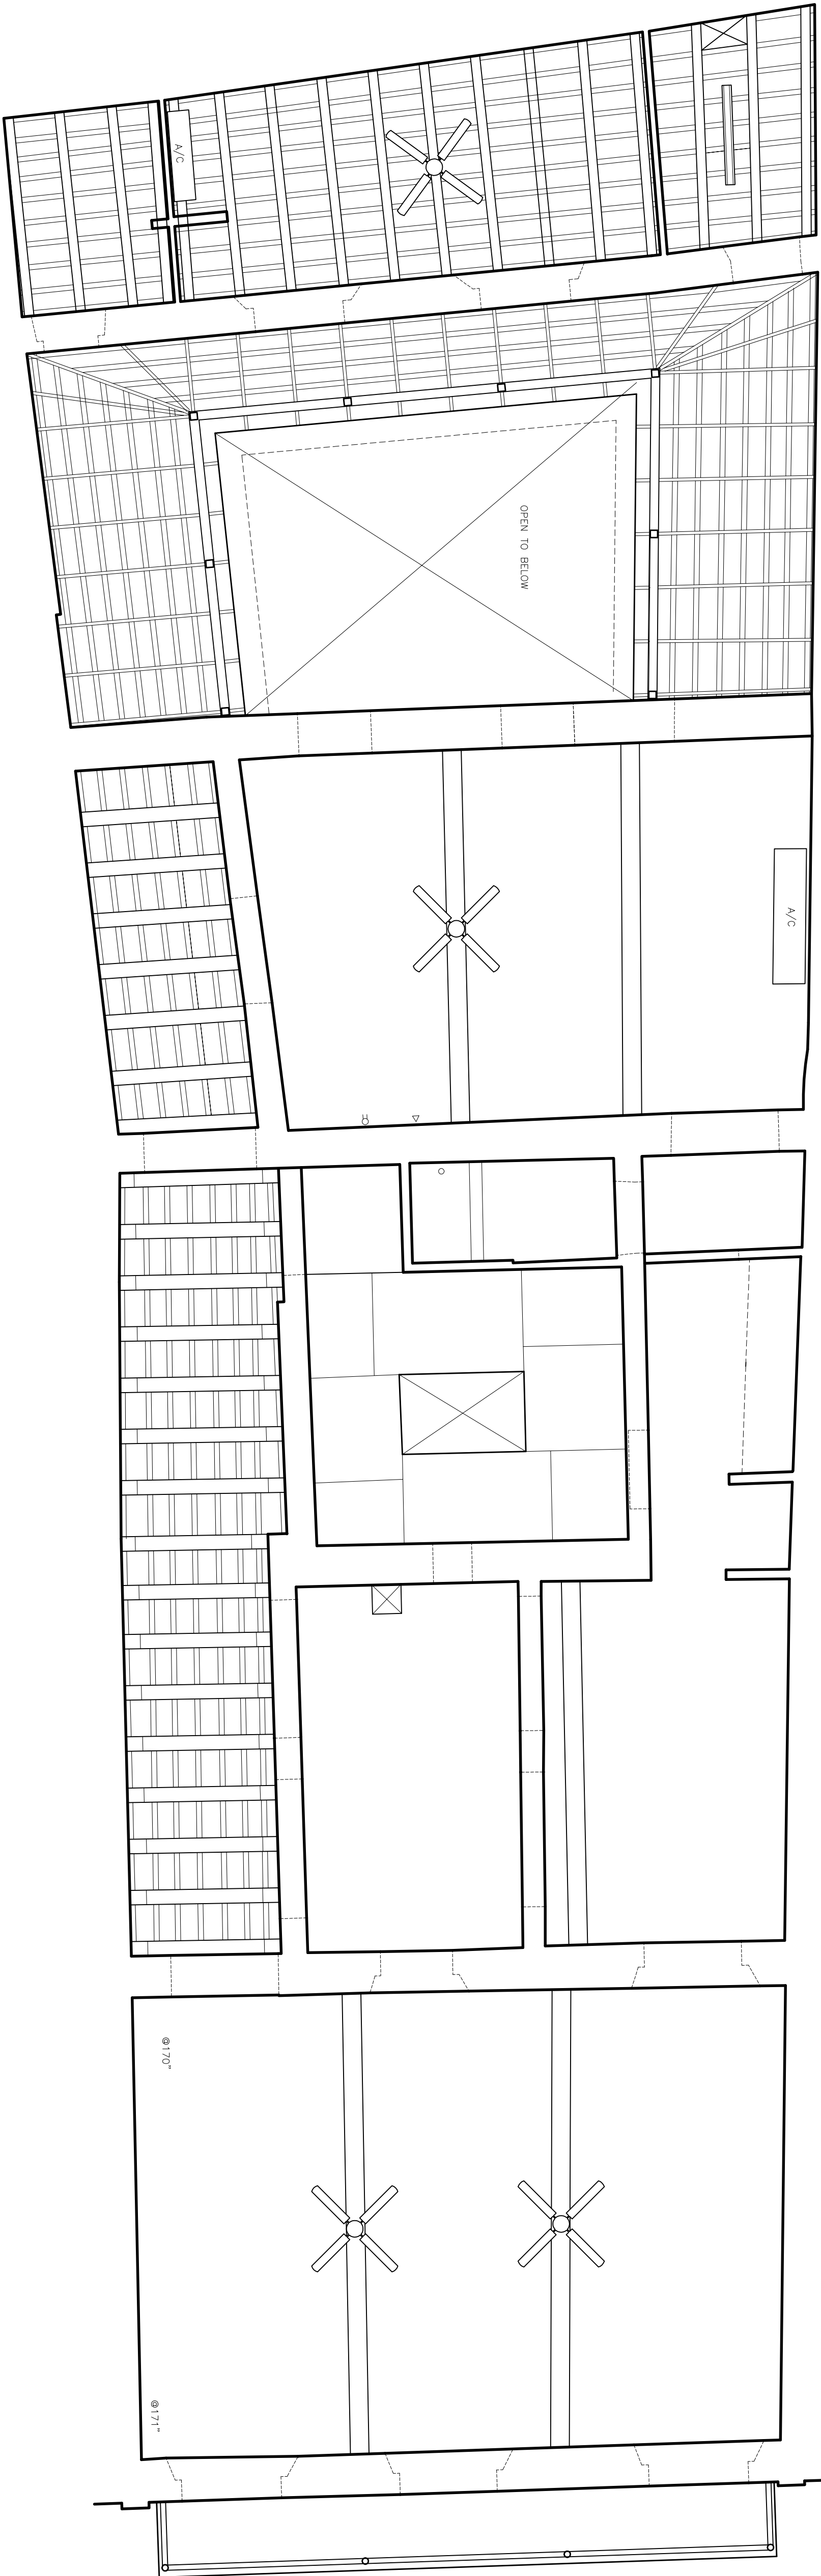

Second Floor Plan Reflected Ceiling

Scale: 1/4"=1'-0"

OWNER:

Cherif Medawar

CONSULTANTS

Arq. Rodolfo Lugo Echizenoid

(787) 562-9373 / rechezo@aig.com

PROJECT:

#251 Del Cristo St., Old San Juan
As Built Drawings
San Juan, P.R.

REVISIONS


NO.	DATE
1	
2	
3	
4	
5	

NOTES / PERMITS

DATE: January 6, 2017


Second Floor
Plan & R.
Ceiling
(As Built)

HOUJA:

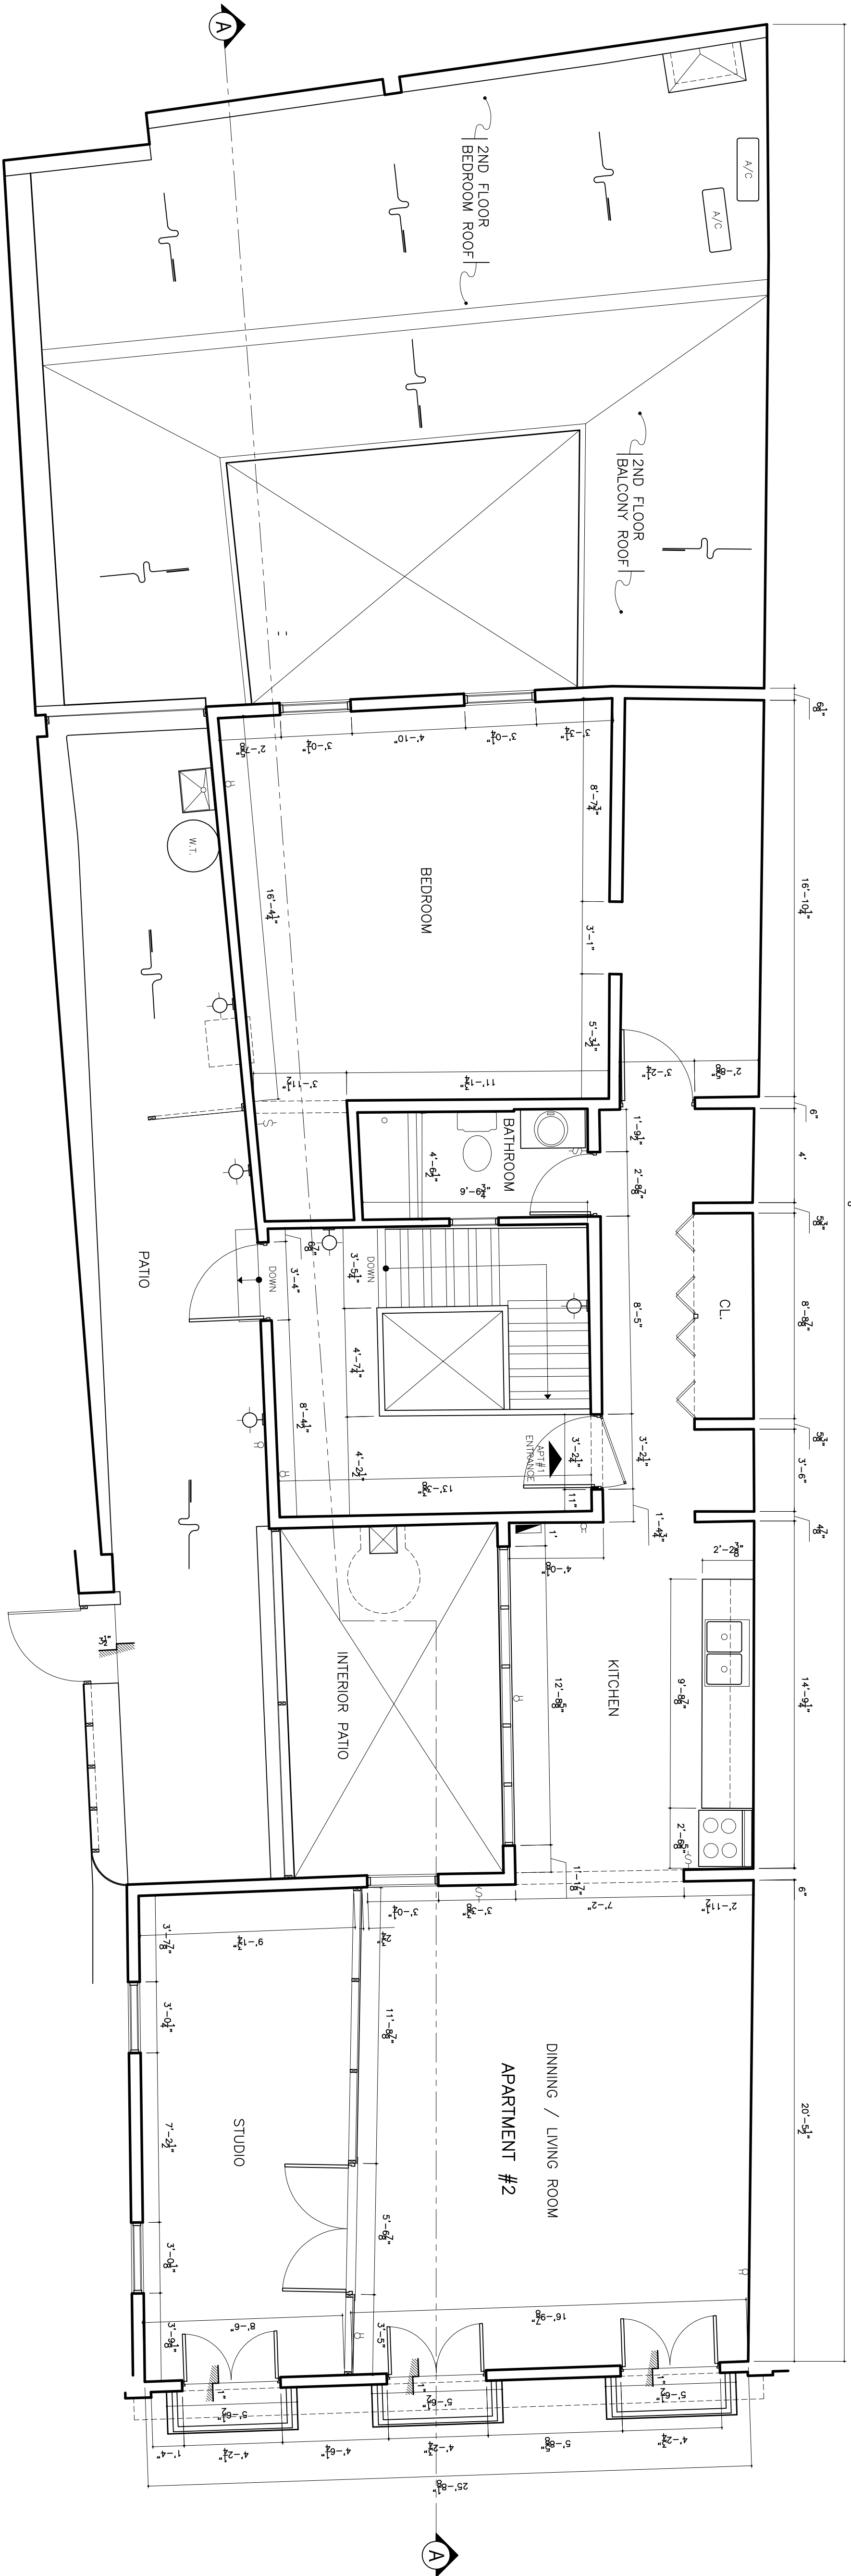

Third Floor Plan NET AREA: 1,886 SQ.FT.

Scale: 1/4"=1'-0"

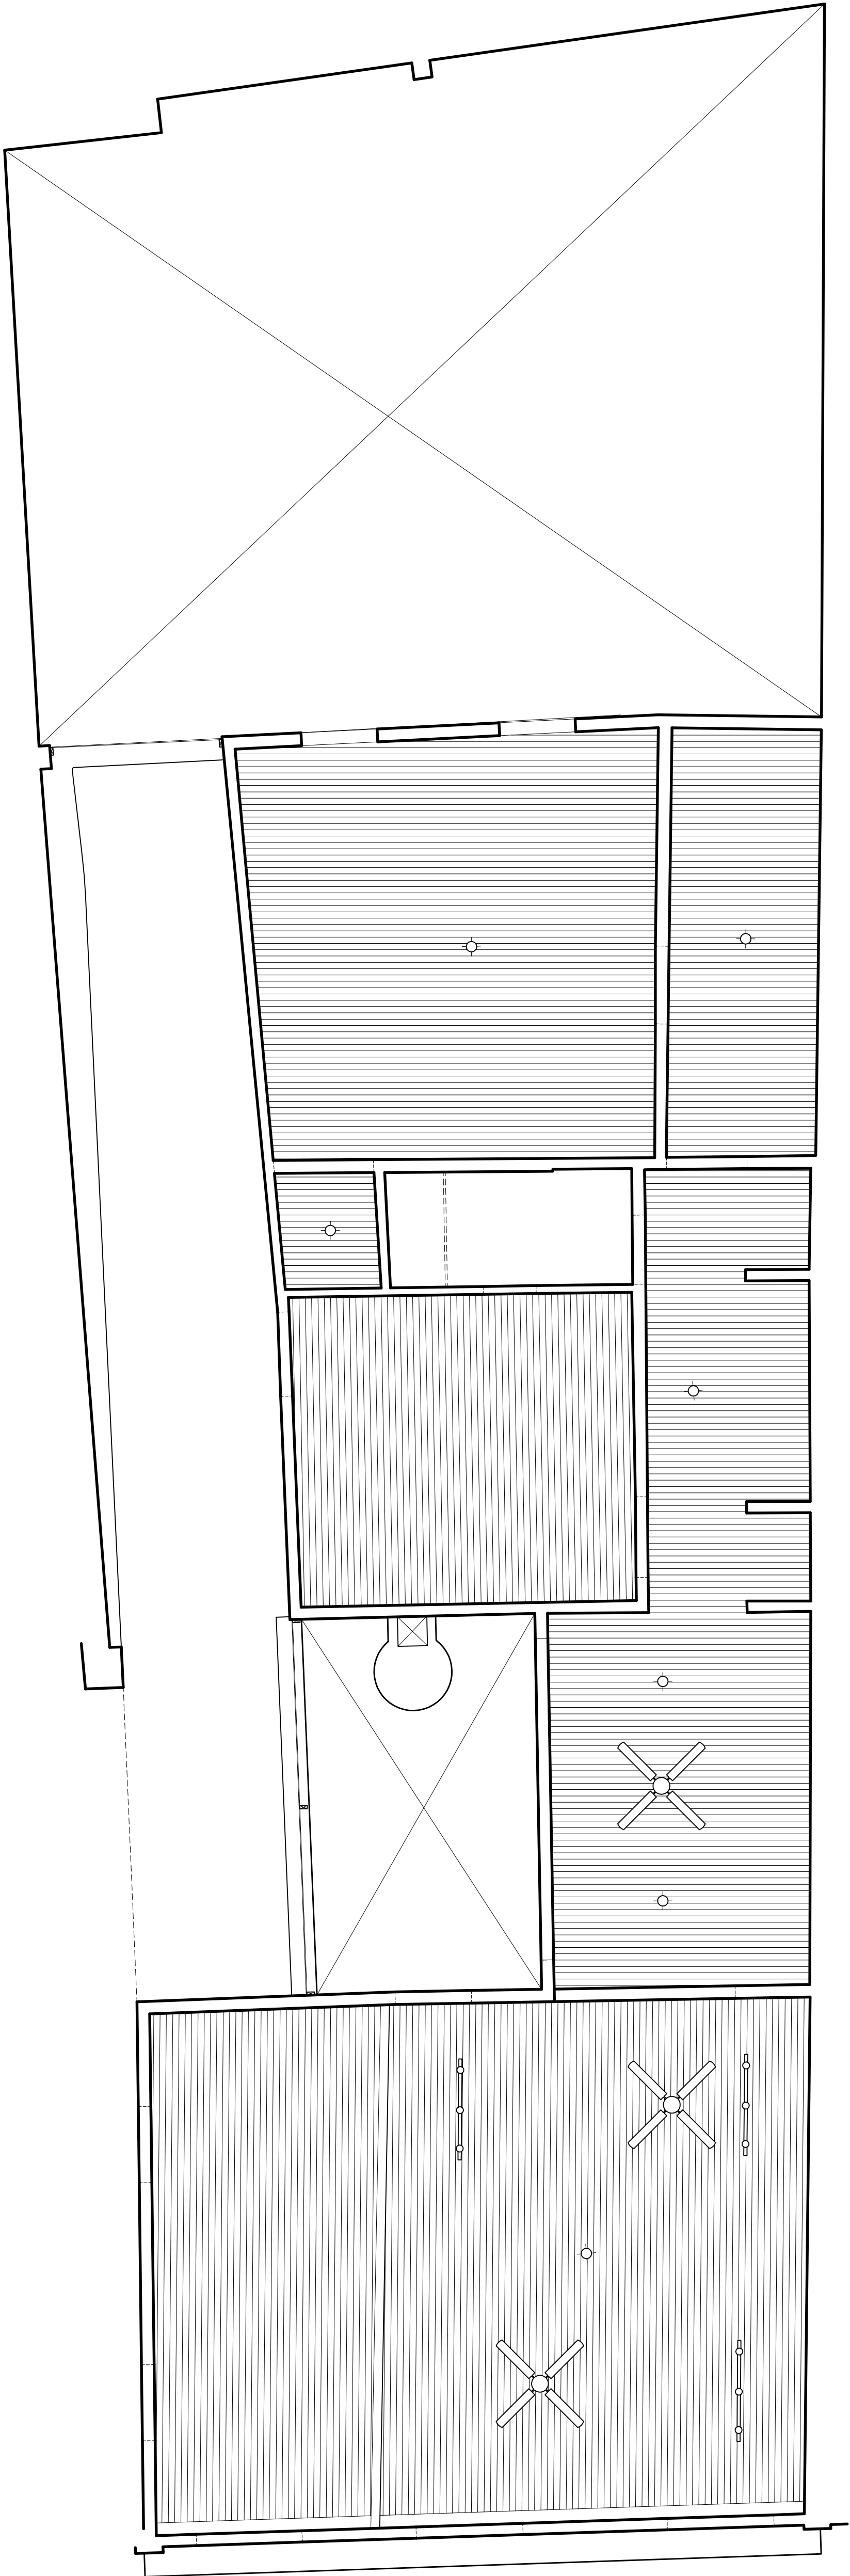

Third Floor Plan
Reflected Ceiling

Scale: 1/4"=1'-0"

OWNER:

Cherif Medawar

CONSULTANTS

Ara Rodríguez Lugo Eschenwald

(787) 554-2471 / arodriguez@pmad.com

PROJECT:

#251 Del Cristo St., Old San Juan
As Built Drawings
San Juan, P.R.

REVISIONS


NO.	DATE
1	
2	
3	
4	
5	

NOTES / PERMITS

DATE: January 6, 2017


Third Floor
Plan & R.
Ceiling
(As Built)

HOJA:

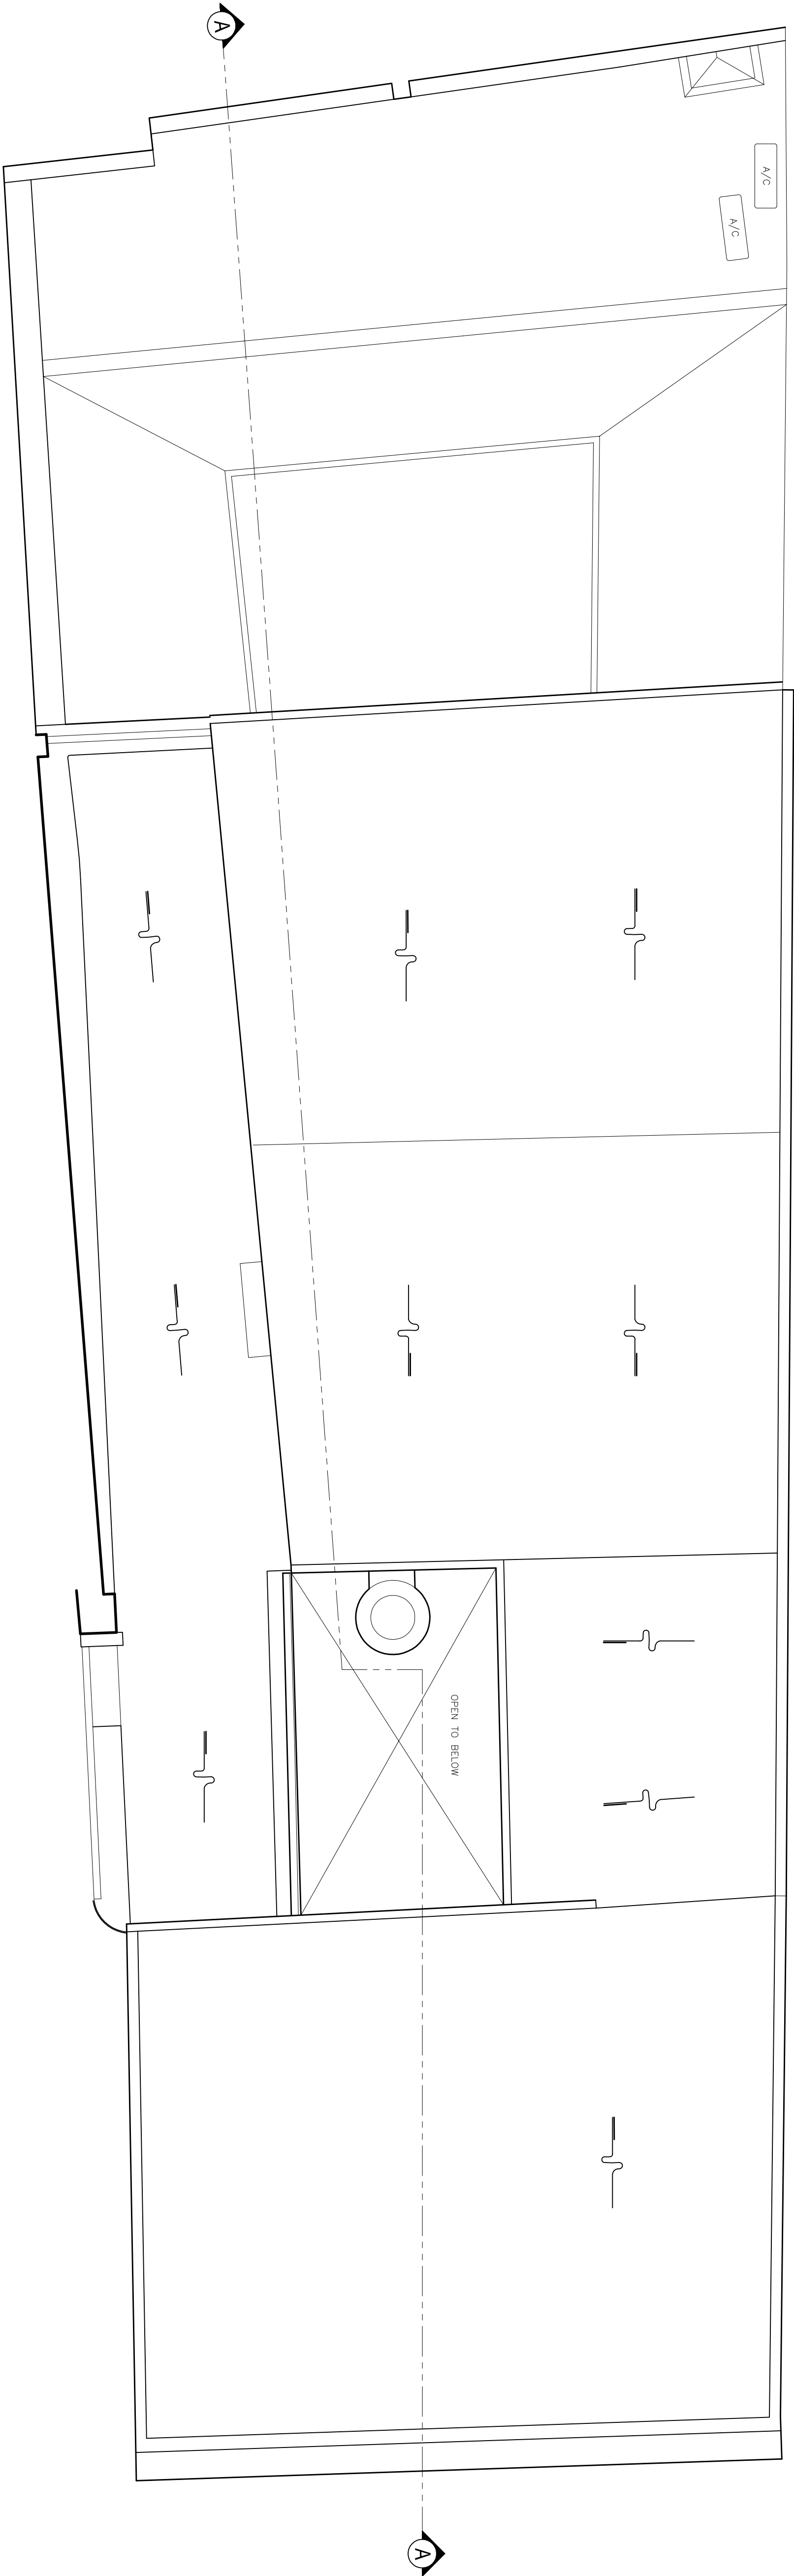

Roof Plan

Scale: 1/4"=1'-0"

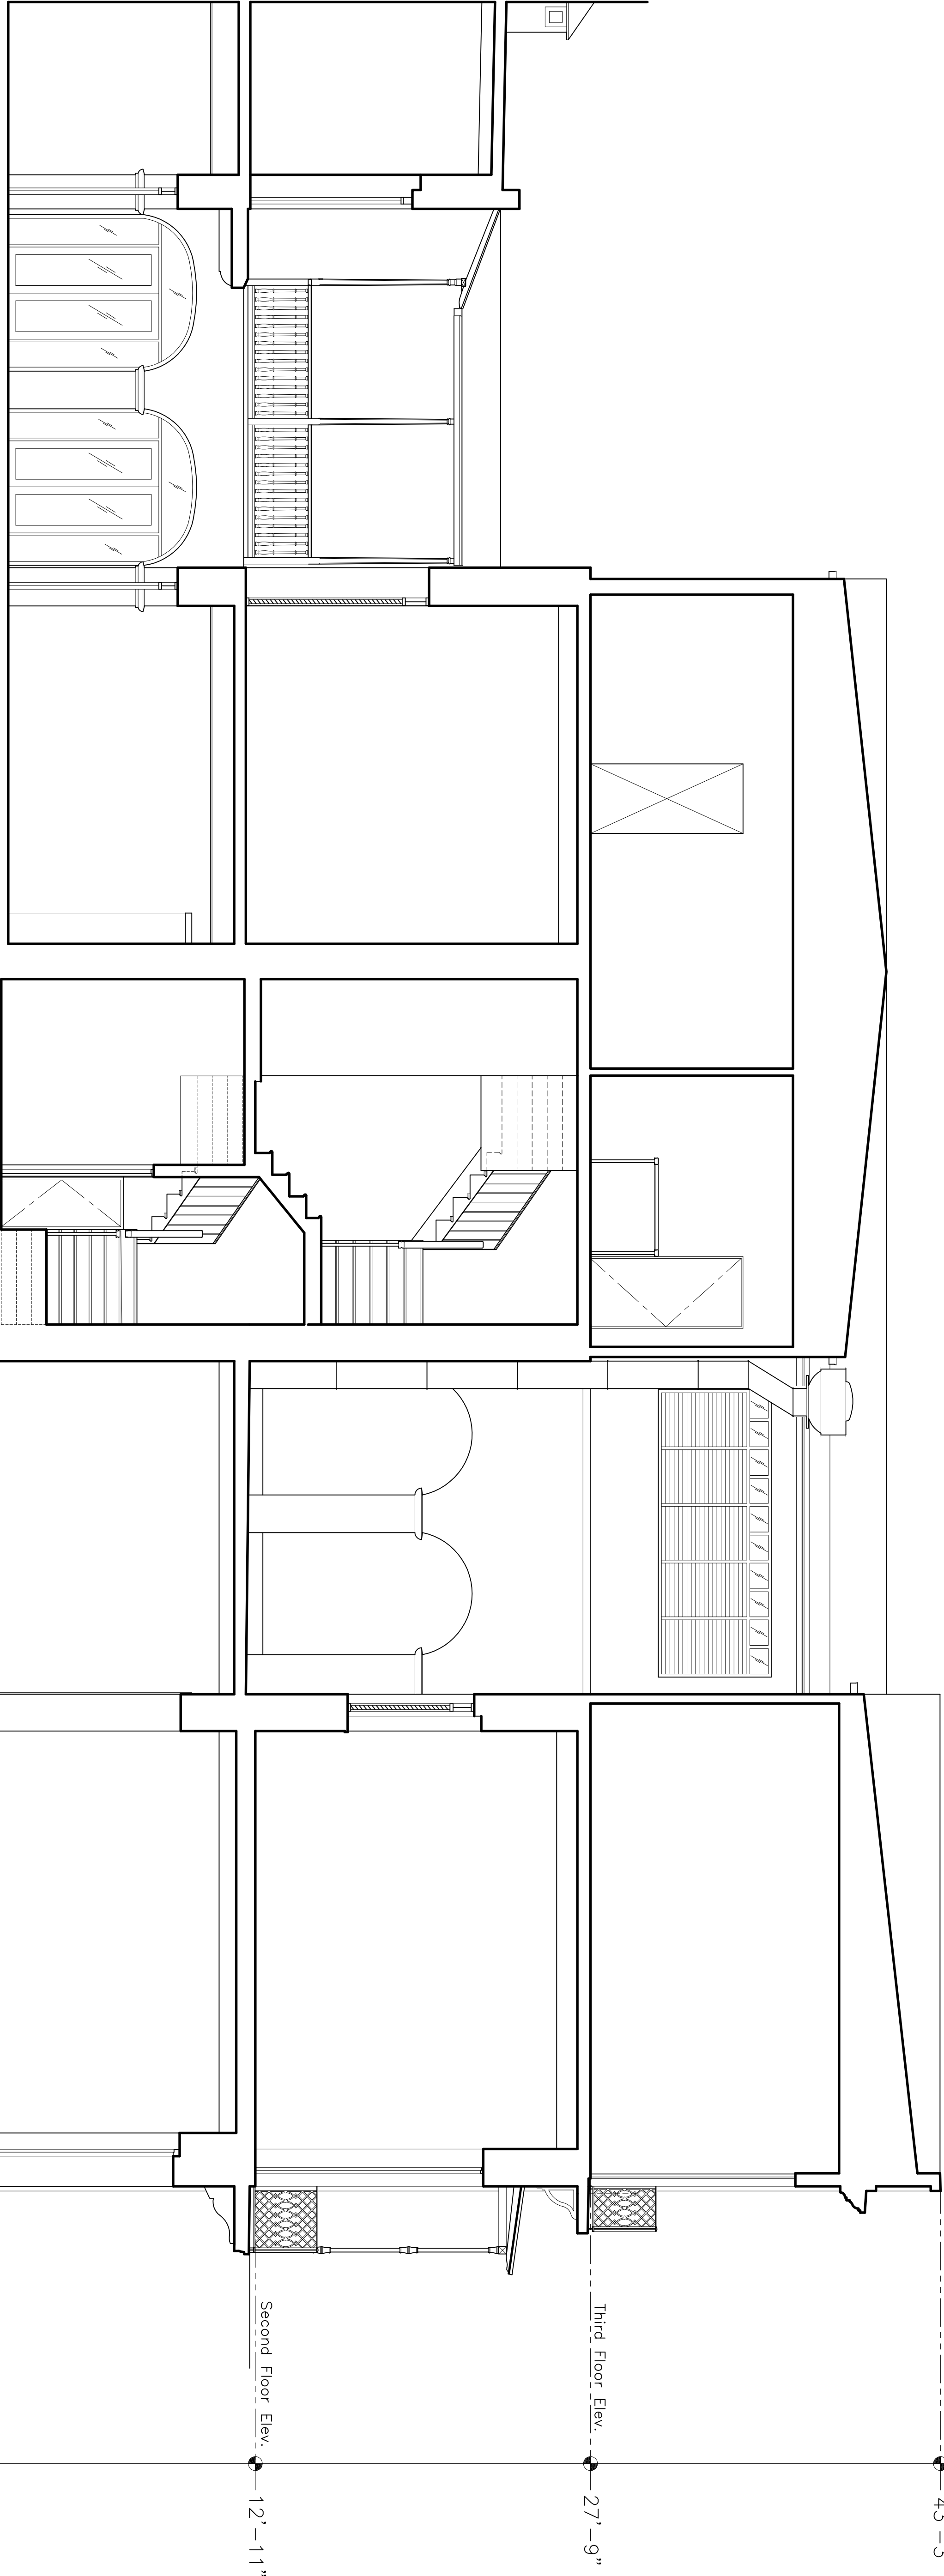

Section A-A

Scale: 1/4"=1'-0"

OWNER:

Cherif Medawar

CONSULTANTS

Arq. Rodolfo Lugo Echivardid

(787) 562-5273 / recheivardid@gmail.com

PROJECT:

#251 Del Cristo St., Old San Juan

As Built Drawings

San Juan, P.R.

REVISIONS

NO.	DATE
1	
2	
3	
4	
5	


NOTES / PERMITS

DATE: January 6, 2017


Roof Plan &
Sect. A-A
(As Built)

NOJA:


A-4

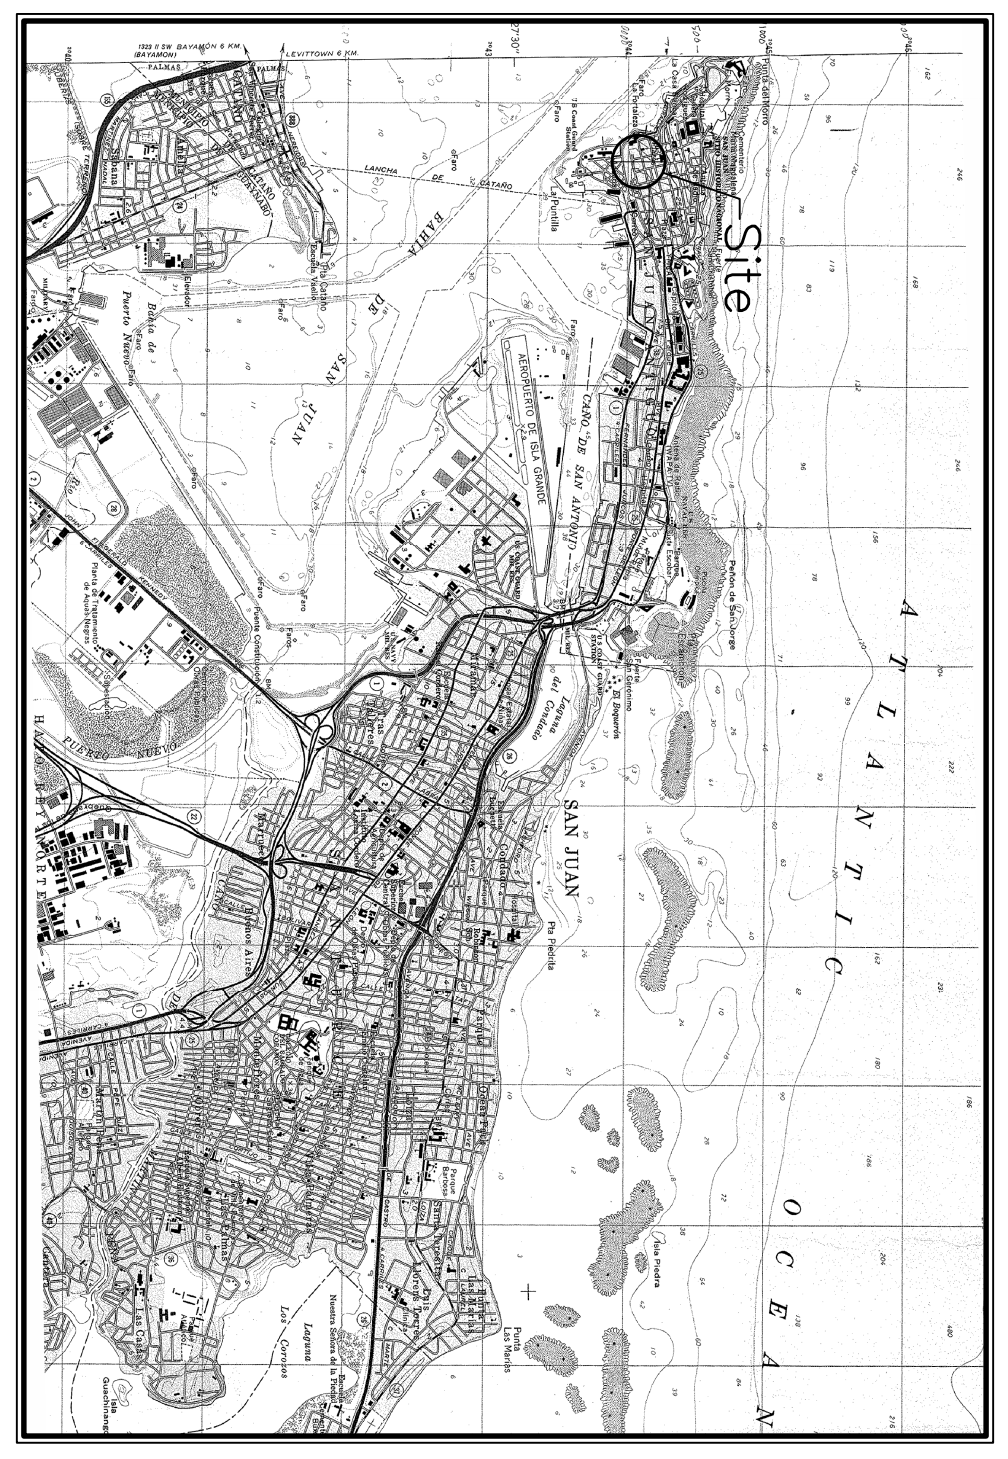


USGS Quadrangle Map (No.83 X235688.8367, Y269933.0585)

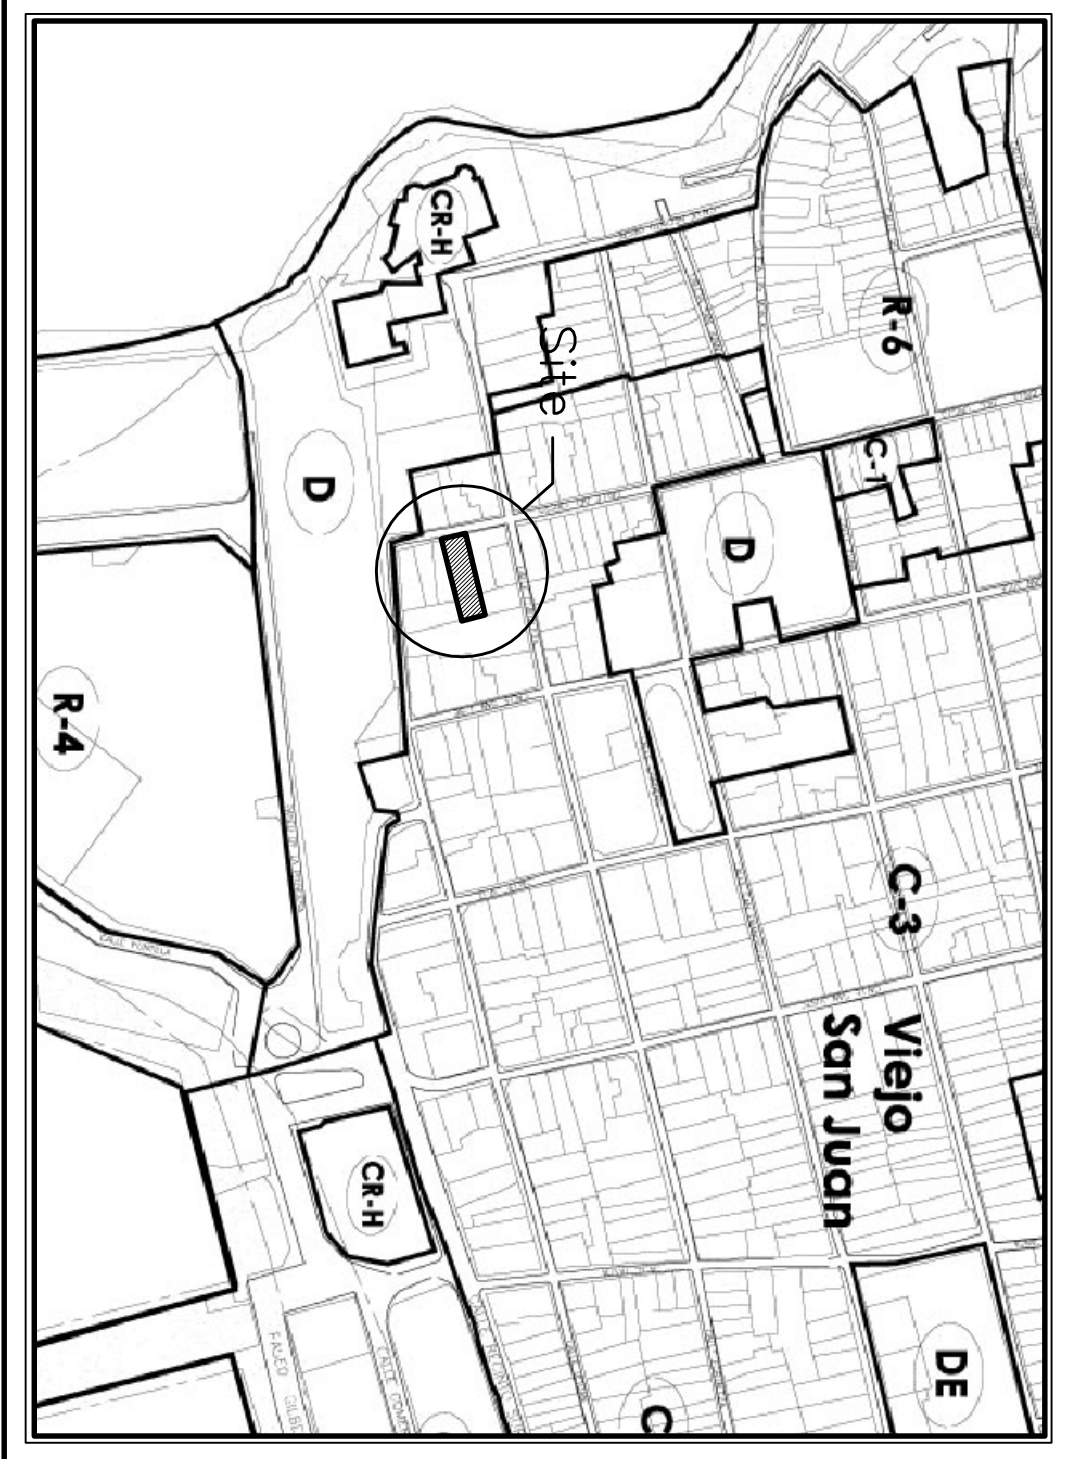

Zoning Map (Sheet 3D and 3E / August 4, 2013 and March 2, 2014)

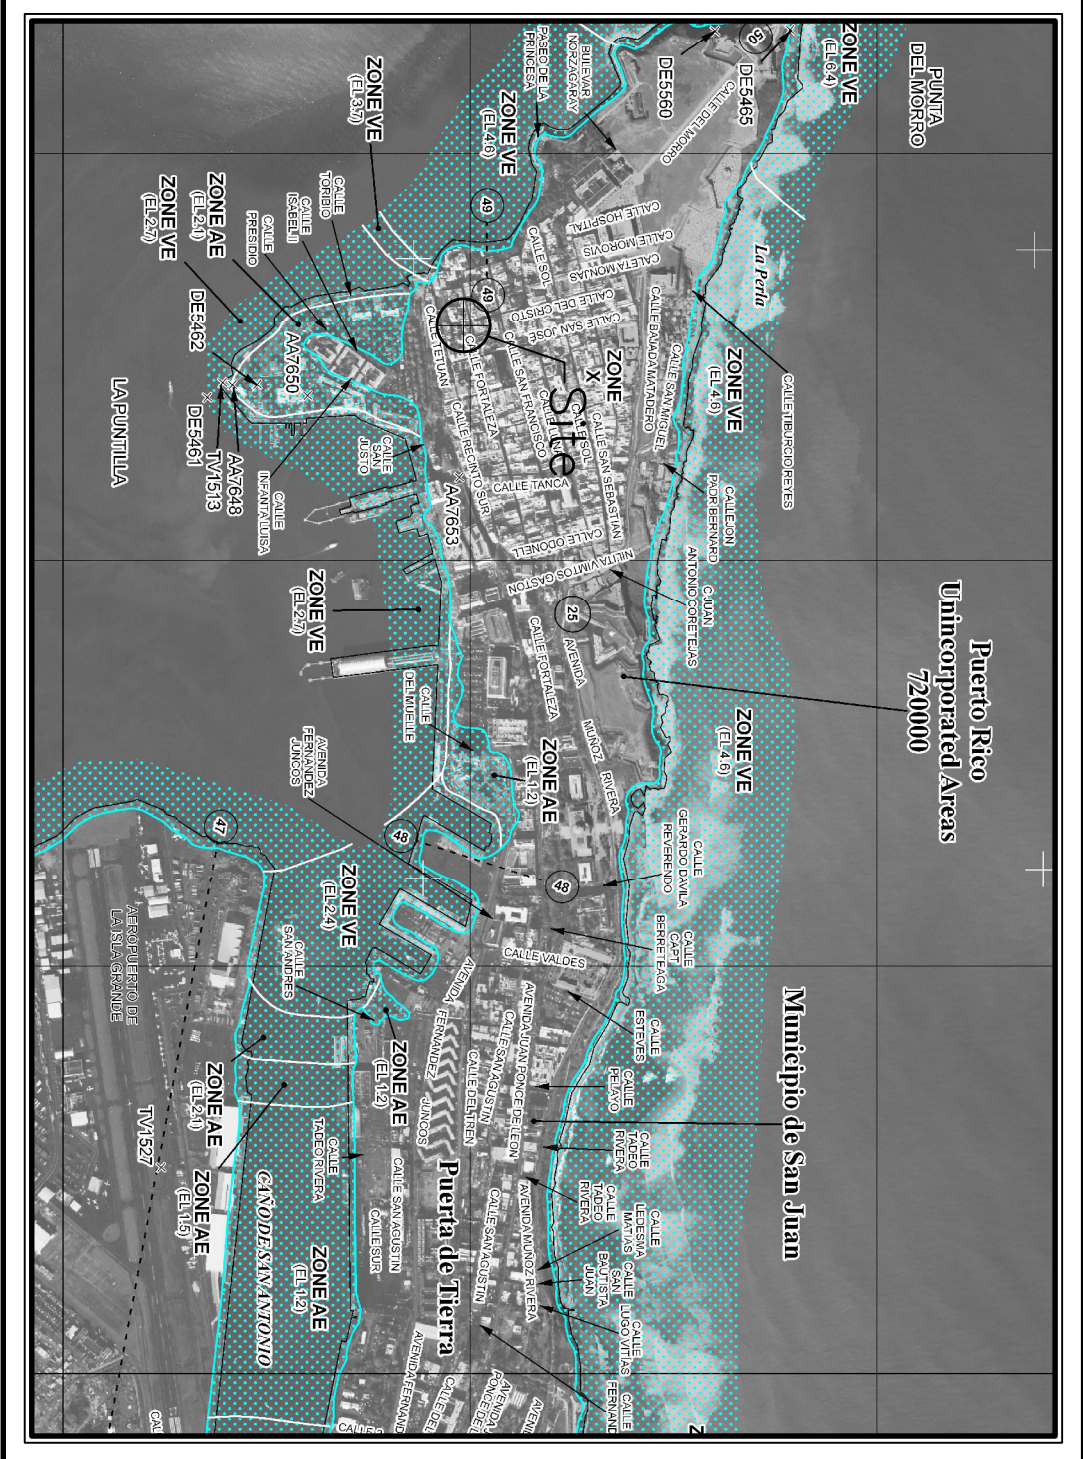

Flood Map (C0007C0355J) November, 18, 2009

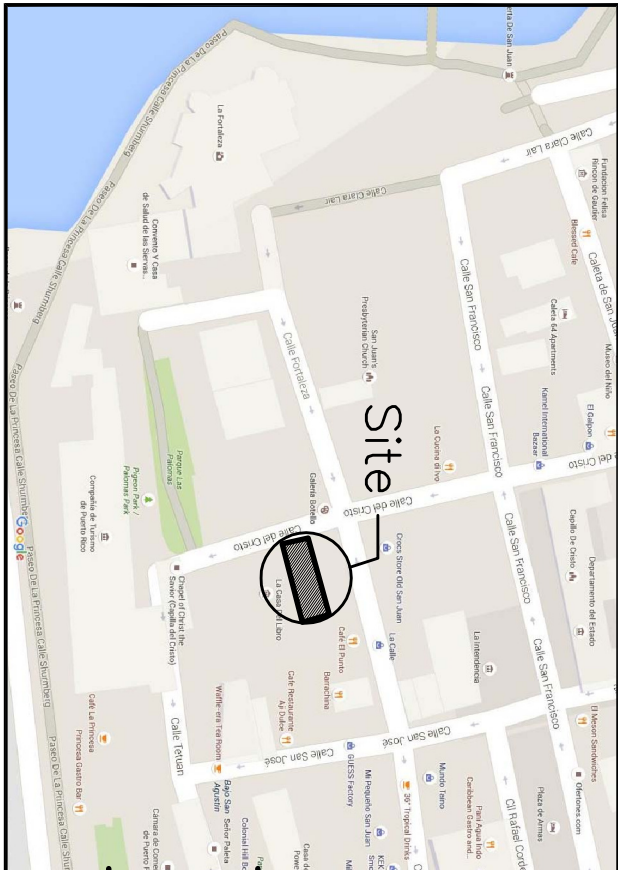


Map of Puerto Rico

Location

#251del Cristo St,
Old San Juan, PR.

Catastro

040-002-052-26

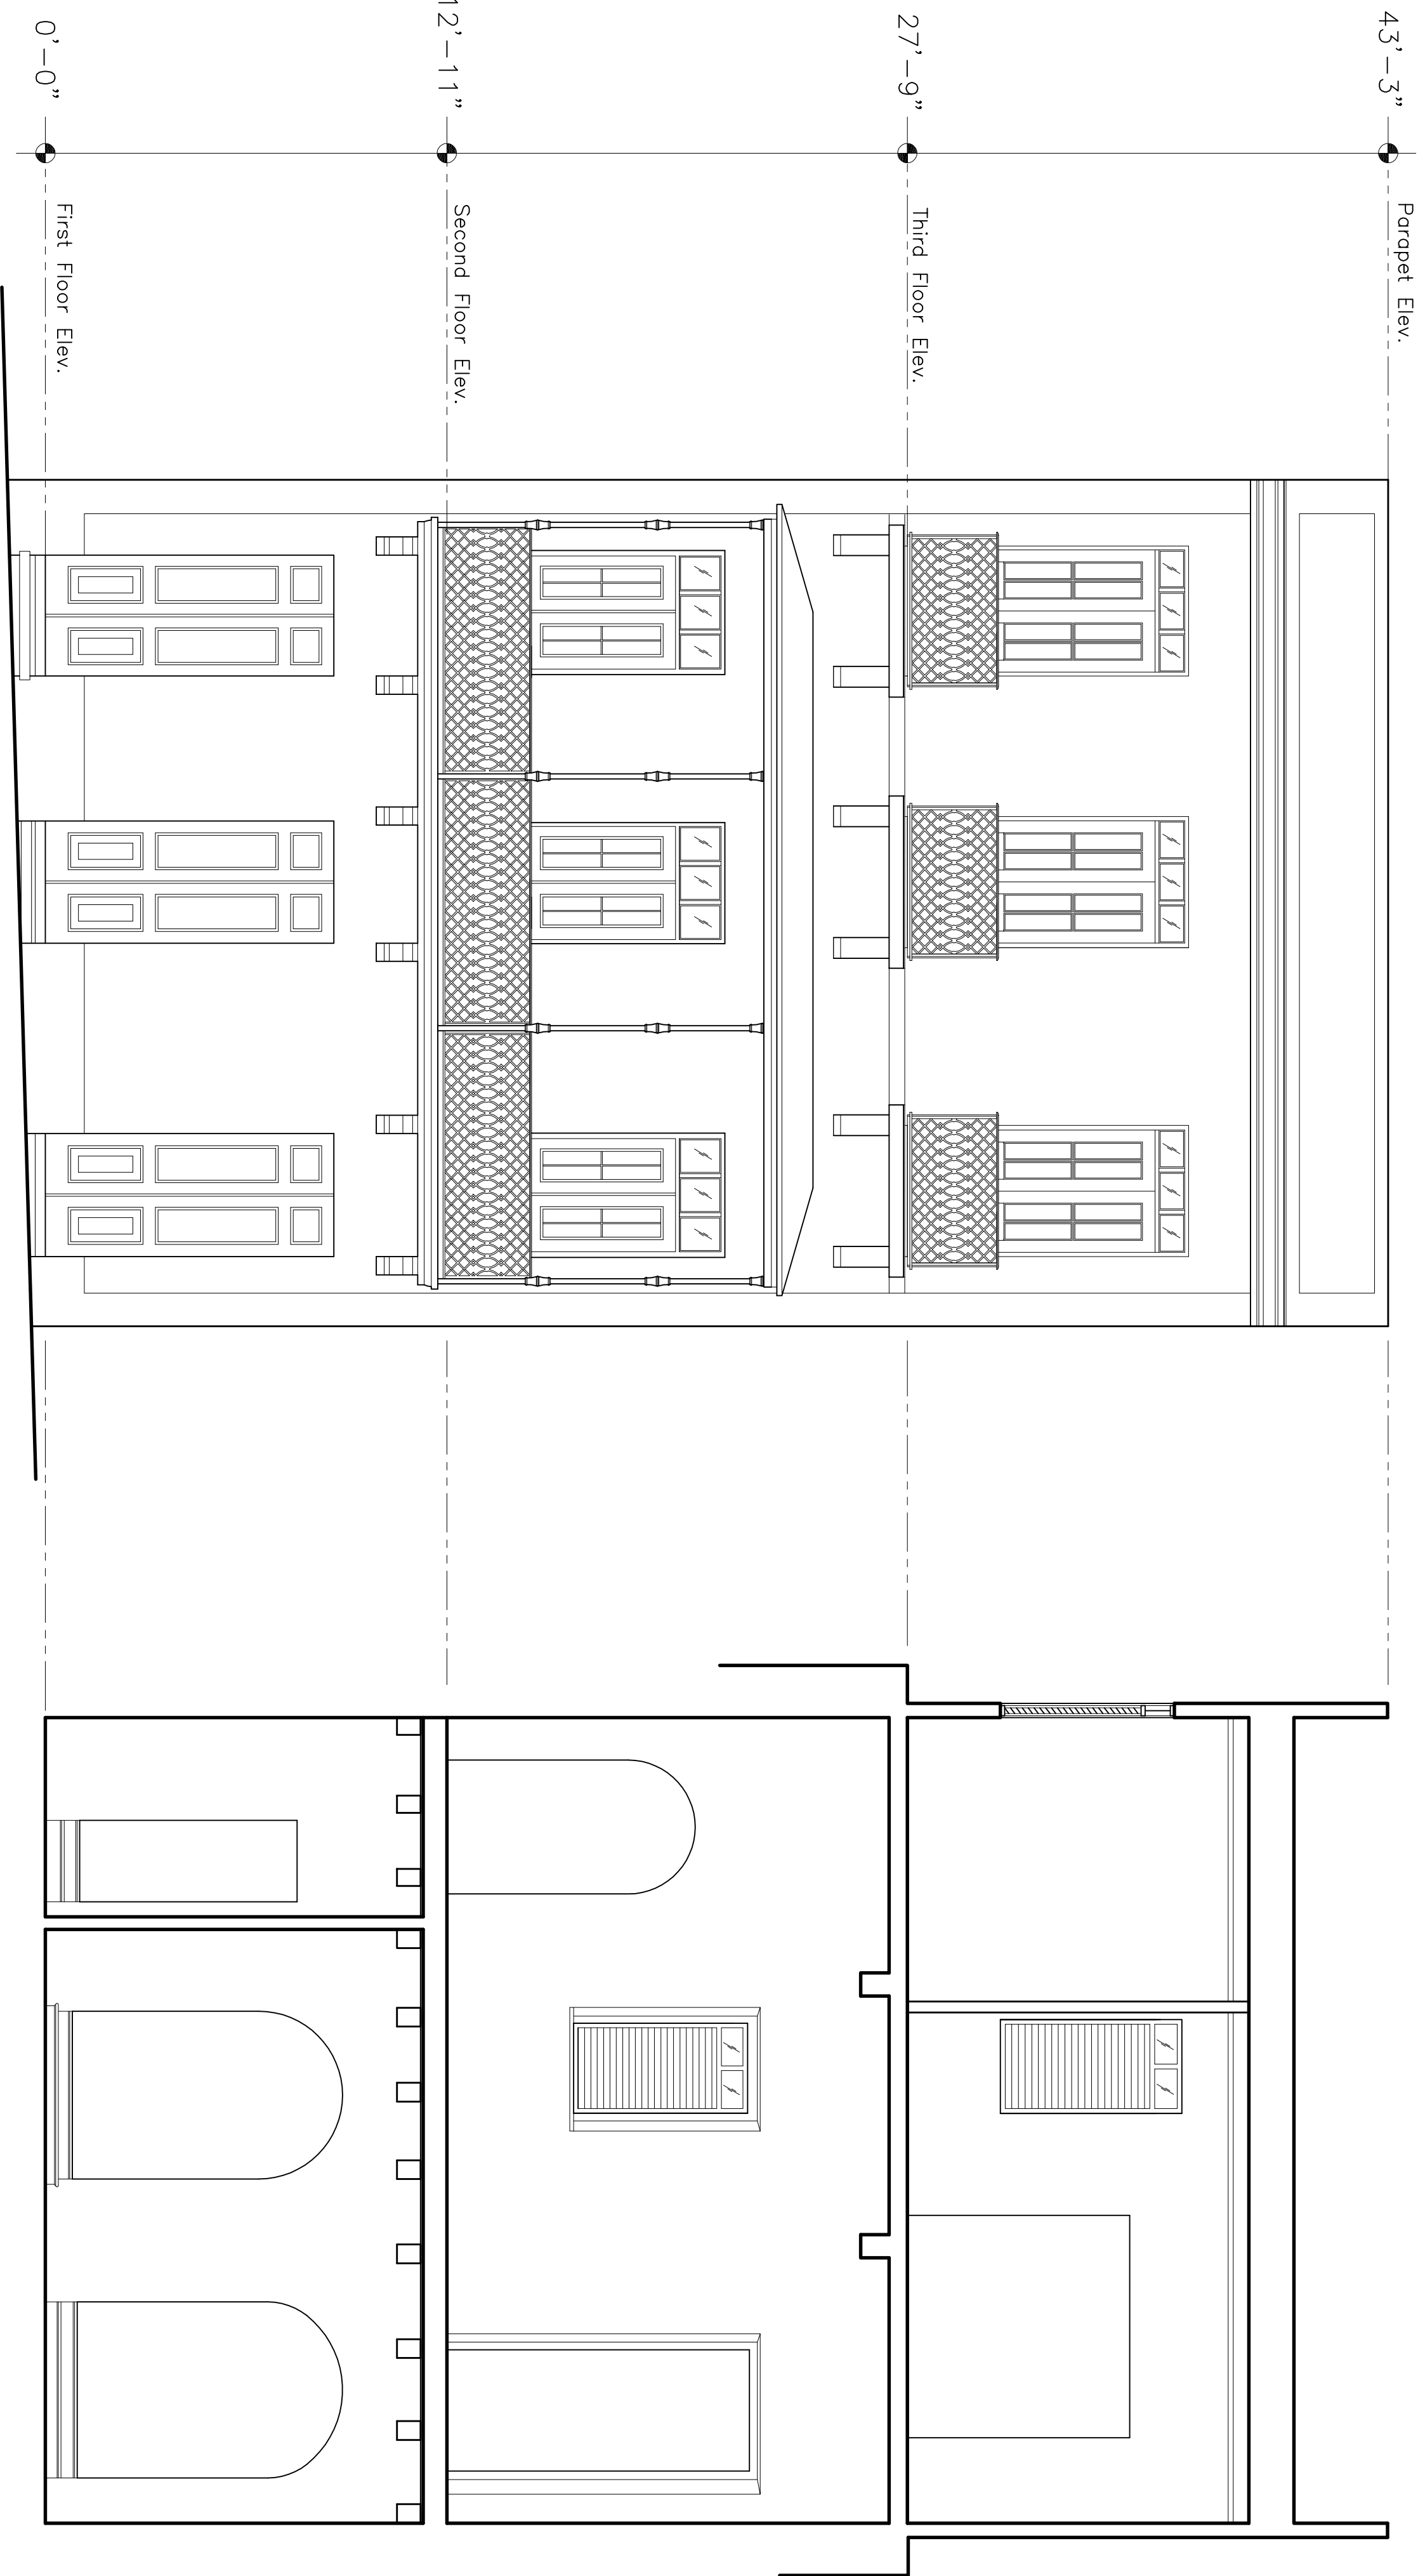

Tanca St. Existing Elevation

Scale: 1/2"=1'-0"

INDEX	
No.	Title
H1-1	TITLE SHEET AND ELEVATION
A-1	EXISTING FIRST FLOOR PLAN AND REFLECTED CEILING
A-2	EXISTING SECOND FLOOR PLAN AND REFLECTED CEILING
A-3	EXISTING THIRD FLOOR PLAN AND REFLECTED CEILING
A-4	EXISTING ROOF PLAN AND GENERAL LONGITUDINAL SECTION

#251 Del Cristo St., Old San Juan

As Built Drawings

San Juan, P.R.

LEGEND	
	4'-0" Fluorescent Light
	GENERAL SECTION
	ELEVATION
	NOTE
	FLOOR OR ROOF DRAIN
	STORM DRAIN
	FLOOR PATTERN CHANGE
	110V RECEPTACLE
	TELECOMMUNICATIONS
	WALL LAMP
	CEILING LAMP
	ELECTRICAL PANEL
	SWITCH
	JUNCTION BOX
	HOSE BIB
	SMOKE DETECTOR

OWNER:

Cherif Medawar

CONSULTANTS

Ara Rodonés Lugo Eschismold

(787) 562-6717 / rchrispaul@gmail.com

PROJECT:

#251 Del Cristo St., Old San Juan

As Built Drawings

San Juan, P.R.

REVISIONS

NO.	DATE
1	
2	
3	
4	
5	

NOTES / PERMITS

DATE: October 24, 2015

Title Sheet

NOJA:

TS-1