

OWNER:

Cheif Medowar

CONSULTANTS

Arch. Rodenas Lugo Screenfield

(not for construction or permit)

PROJECT:

#207 Del Cristo St., Old San Juan
As Built Drawings
San Juan, P.R.

REVISIONS

NO.	DATE
1	
2	
3	
4	
5	


NOTES / PERMITS

DATE: October 21, 2016

Existing
Floor Plans
(As Built)


HOUA:

A-1

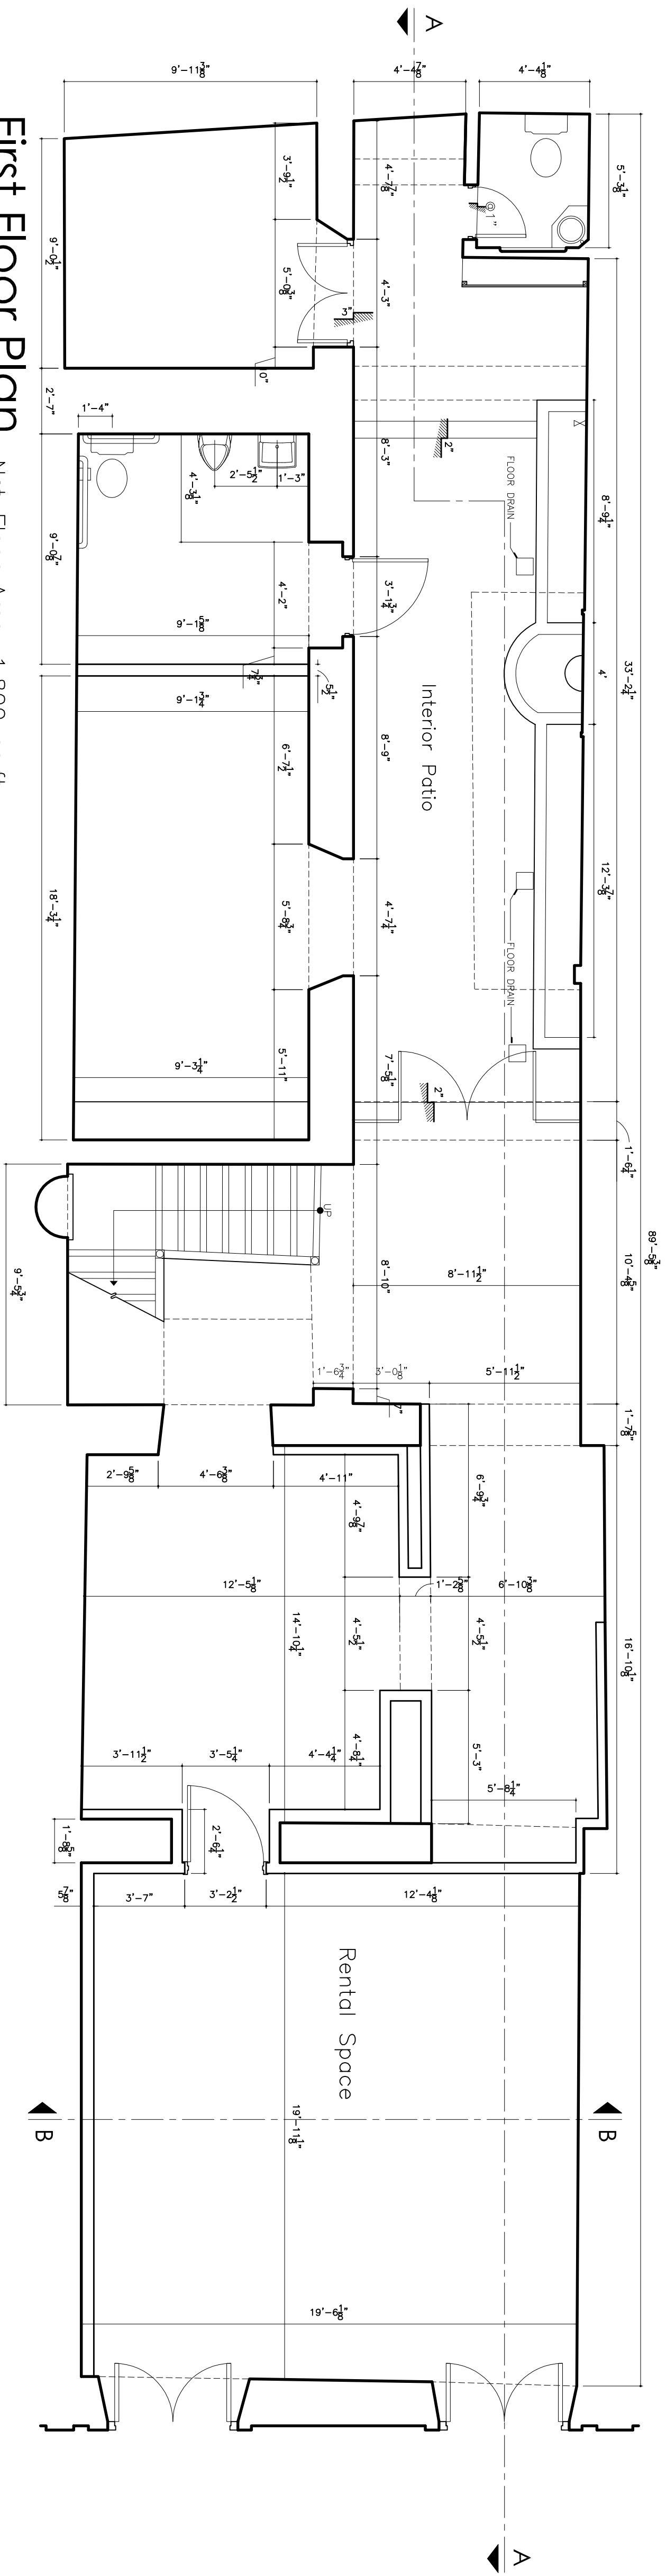


First Floor Plan Net Floor Area: 1,800 sq.ft.

Scale: 1/4"=1'-0"

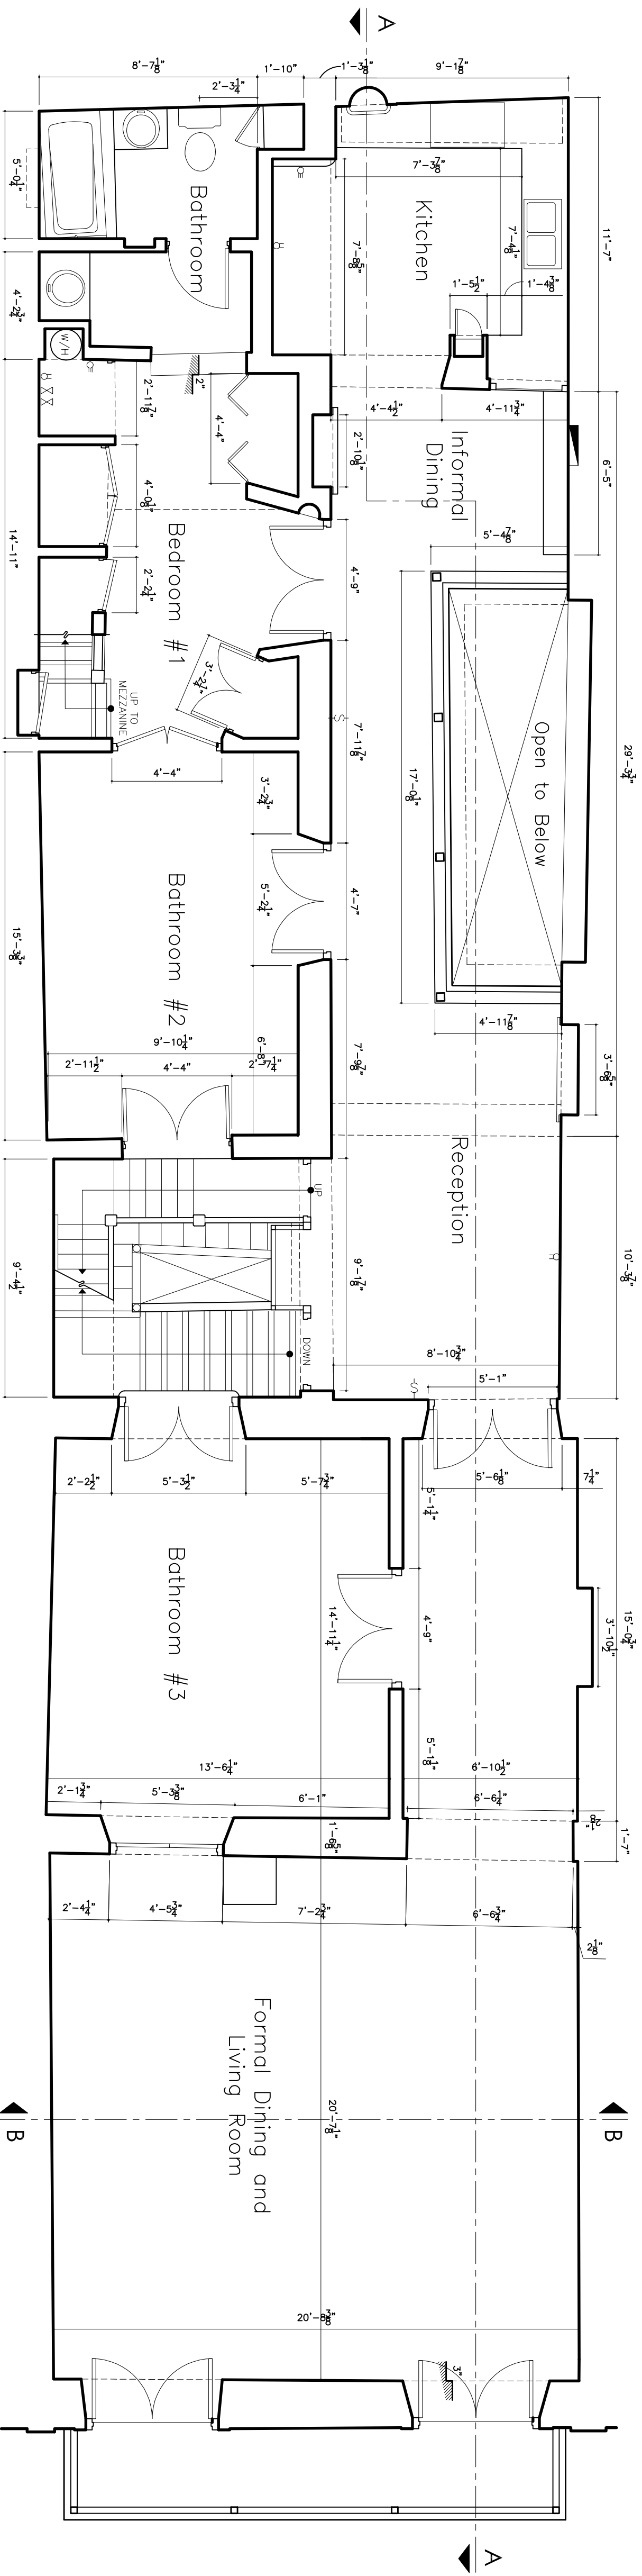


Second Floor Plan Net Floor Area: 1,883 sq.ft.

Scale: 1/4"=1'-0"

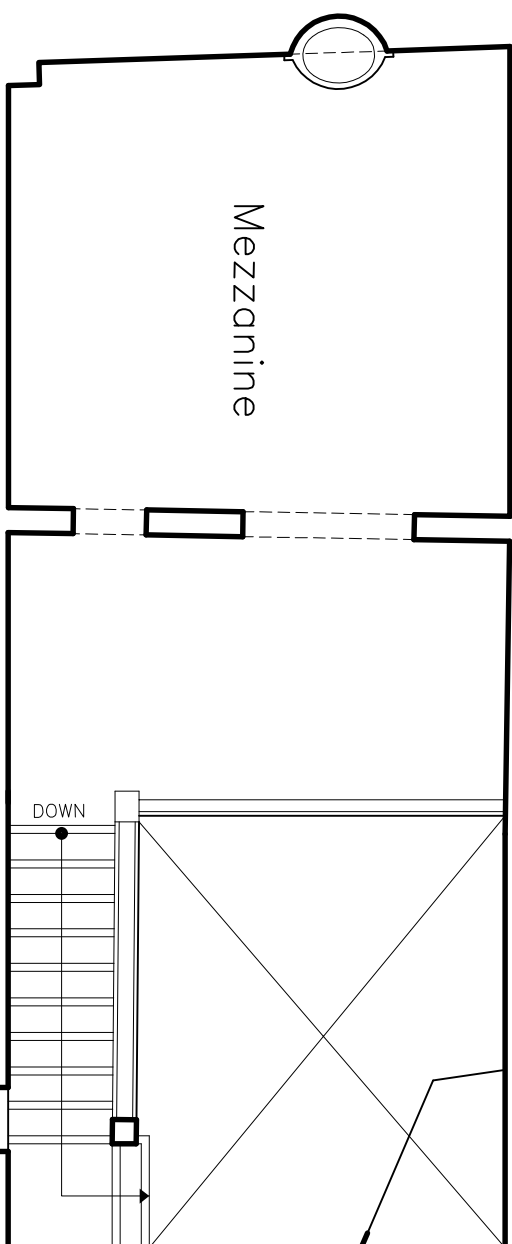


Net Floor Area: 165 sq.ft.

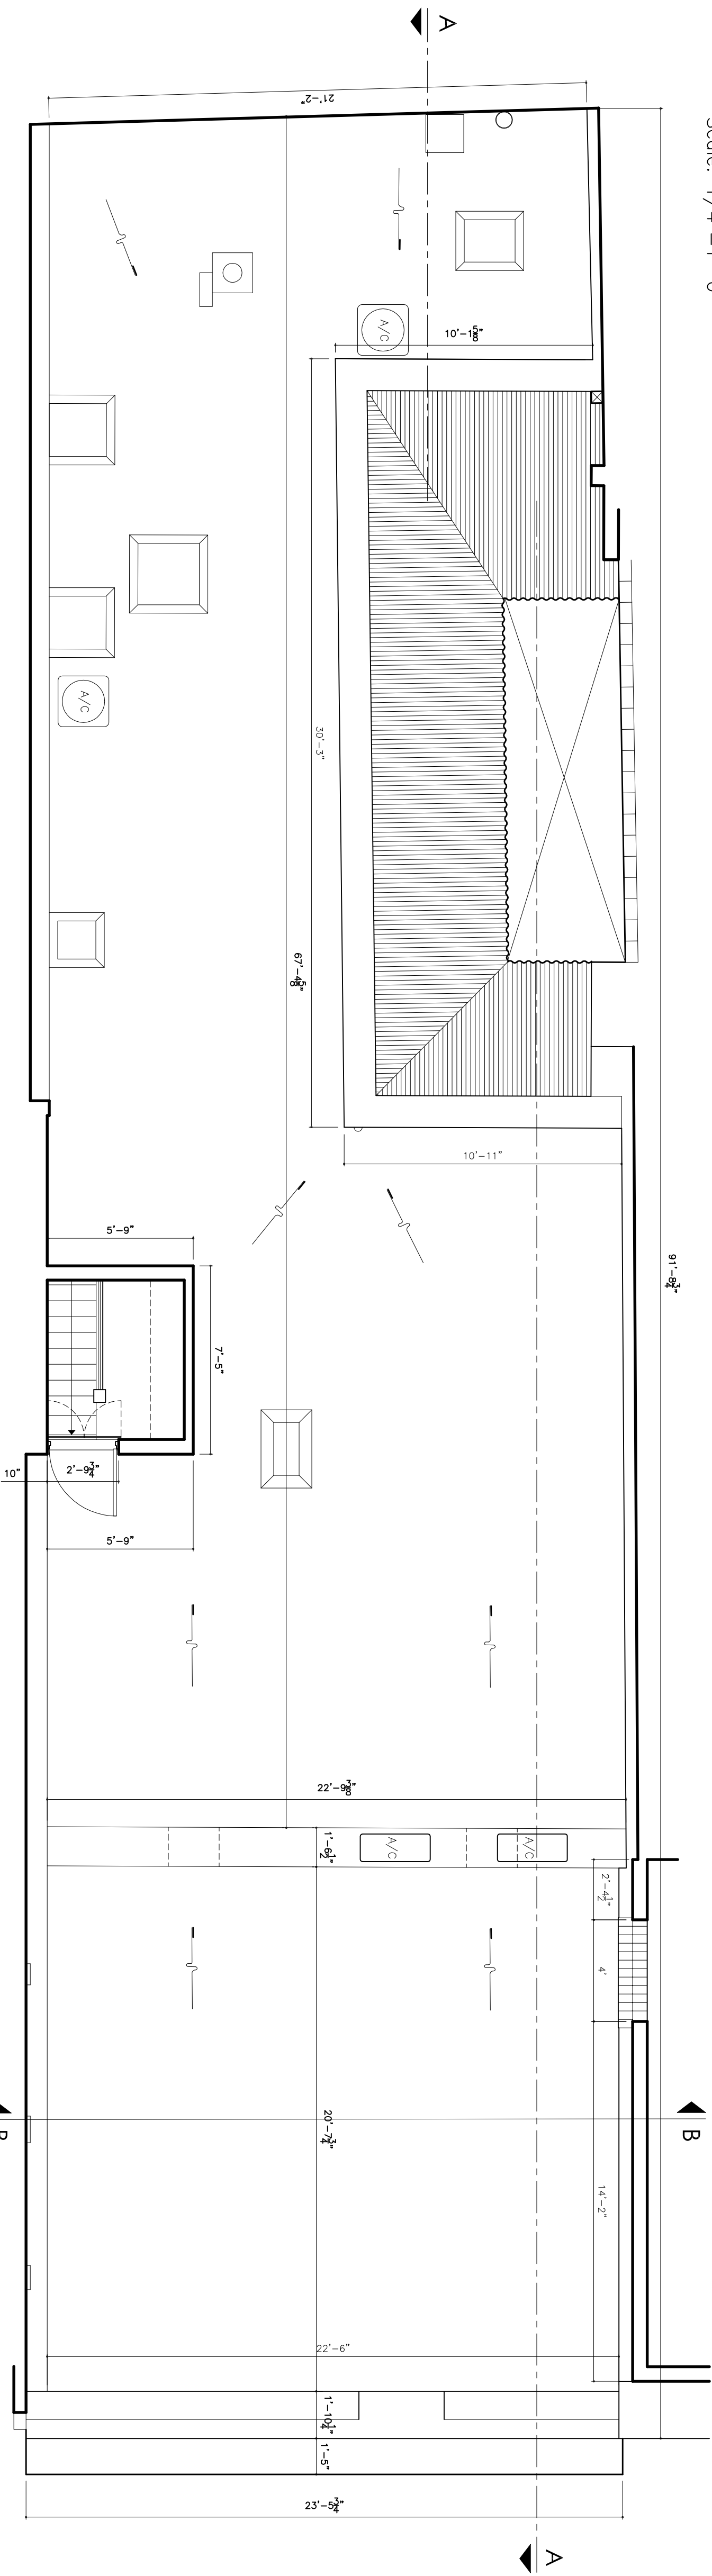


Roof Level Floor Plan Net Floor Area: 2,066 sq.ft.


Scale: 1/4"=1'-0"

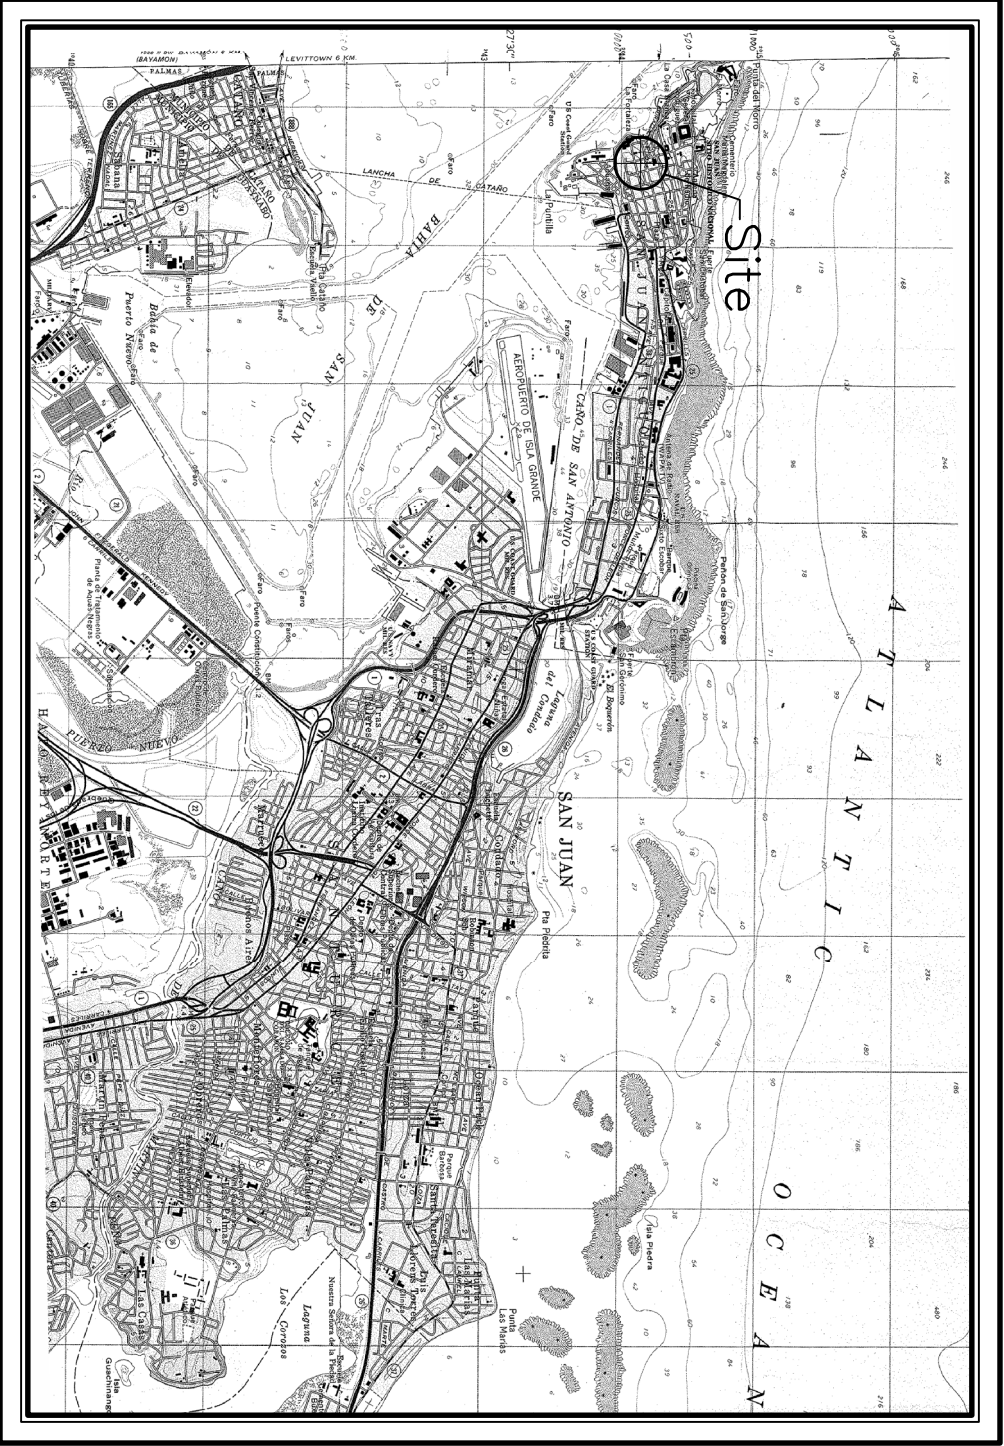


USGS Quadrangle Map (Node3 X:23335 6281, Y:269931 0992)

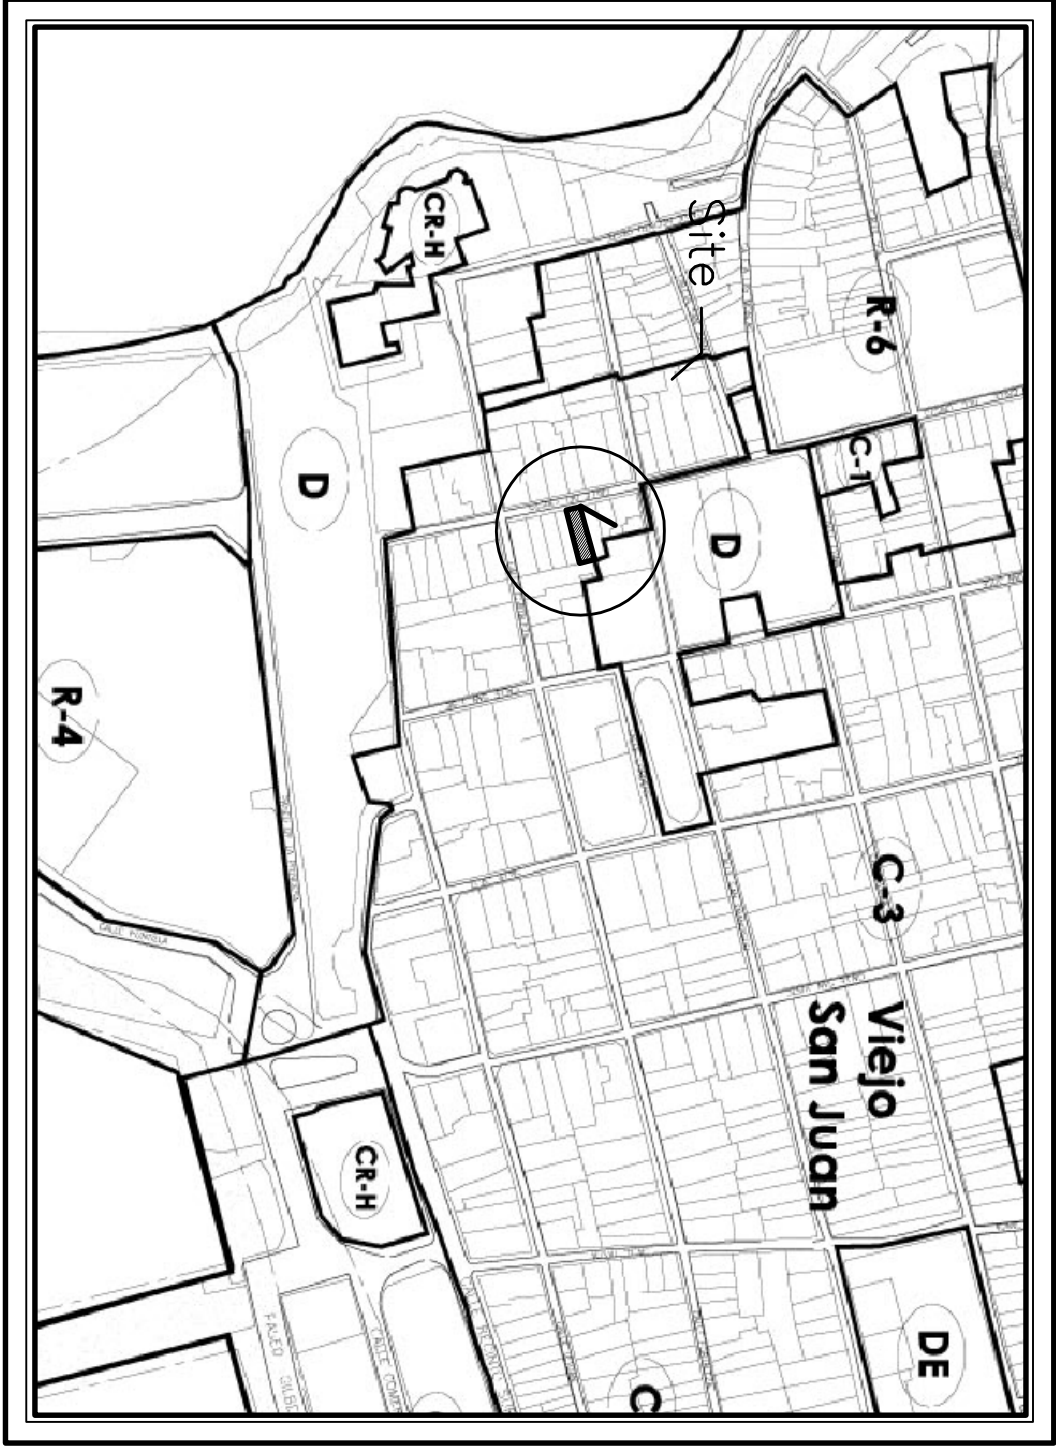

Zoning Map (Sheet 3D and 3E / August 4, 2013 and March 2, 2014)

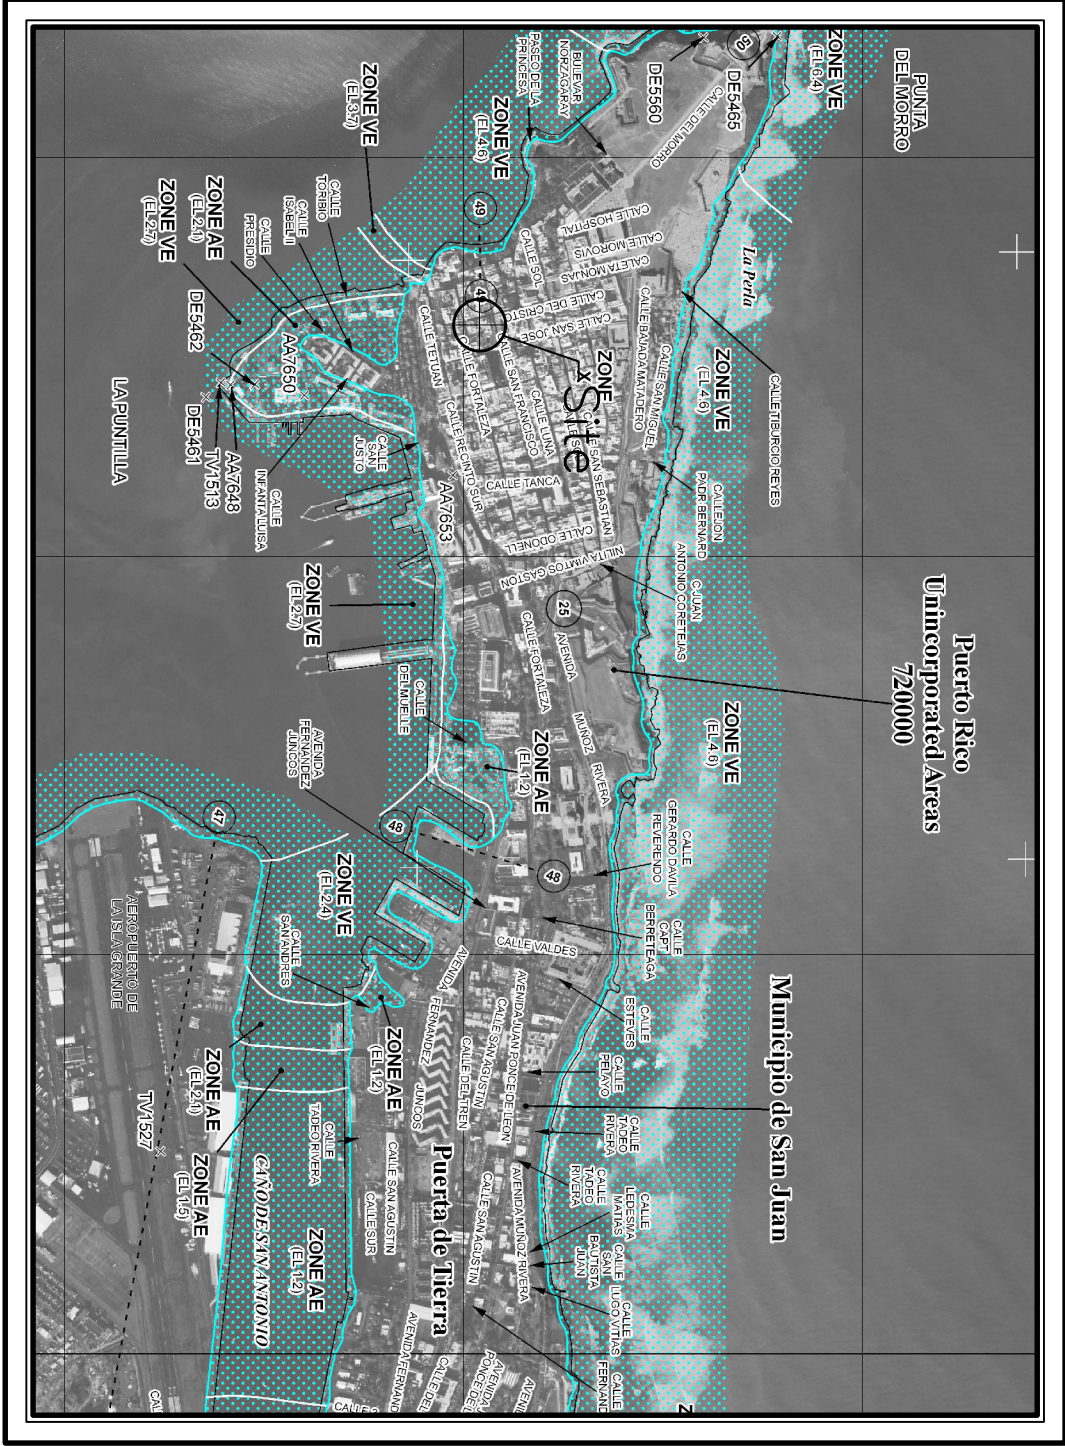

Flood Map (C000703554) November, 18, 2009

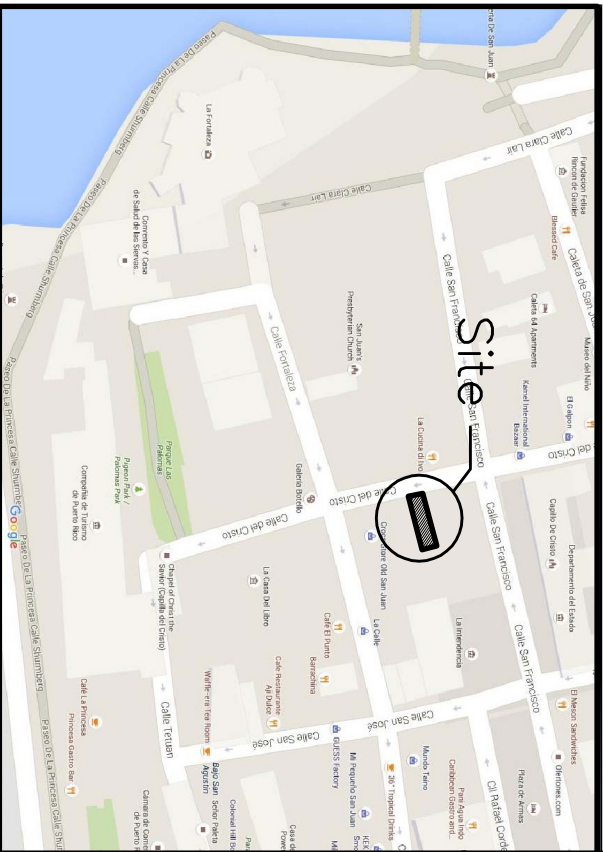

Map of Puerto Rico

#207 Del Cristo St.
Old San Juan, P.R.

Location

Catastro 040-002-043-16

INDEX	
No.	Title
HT-1	TITLE SHEET AND ELEVATION
A-1	EXISTING FLOOR PLANS
A-2	EXISTING REFLECTED CEILINGS
A-3	EXISTING SECTIONS

#207 Del Cristo St., Old San Juan

As Built Drawings

San Juan, P.R.

LEGEND	
	4'-0" Fluorescent Light
	GENERAL SECTION
	ELEVATION
	NOTE
	FLOOR OR ROOF DRAIN
	STORM DRAIN
	FLOOR PATTERN CHANGE
	110V RECEPTACLE
	TELECOMMUNICATIONS
	WALL LAMP
	CEILING LAMP
	ELECTRICAL PANEL
	SWITCH
	JUNCTION BOX
	HOSE BIB

32'-9" Poropet Elev.

Second Floor Elev. 13'-3-1/2"

First Floor Elev. 0'-0"


First Floor Elev. 0'-0"

Del Cristo St. Existing Elevation

Scale: 1/2"=1'-0"


OWNER:	
Cheif Medawar	
CONSULTANTS	
Ana Rodenas Lugo Screenfield ana.rodenas@screenfield.com	
PROJECT:	
#207 Del Cristo St., Old San Juan	
As Built Drawings	
San Juan, P.R.	
REVISIONS	
NO.	DATE
1	
2	
3	
4	
5	
NOTES / PERMITS	

DATE: October 24, 2015
Title Sheet
HOTAS:
TS-1

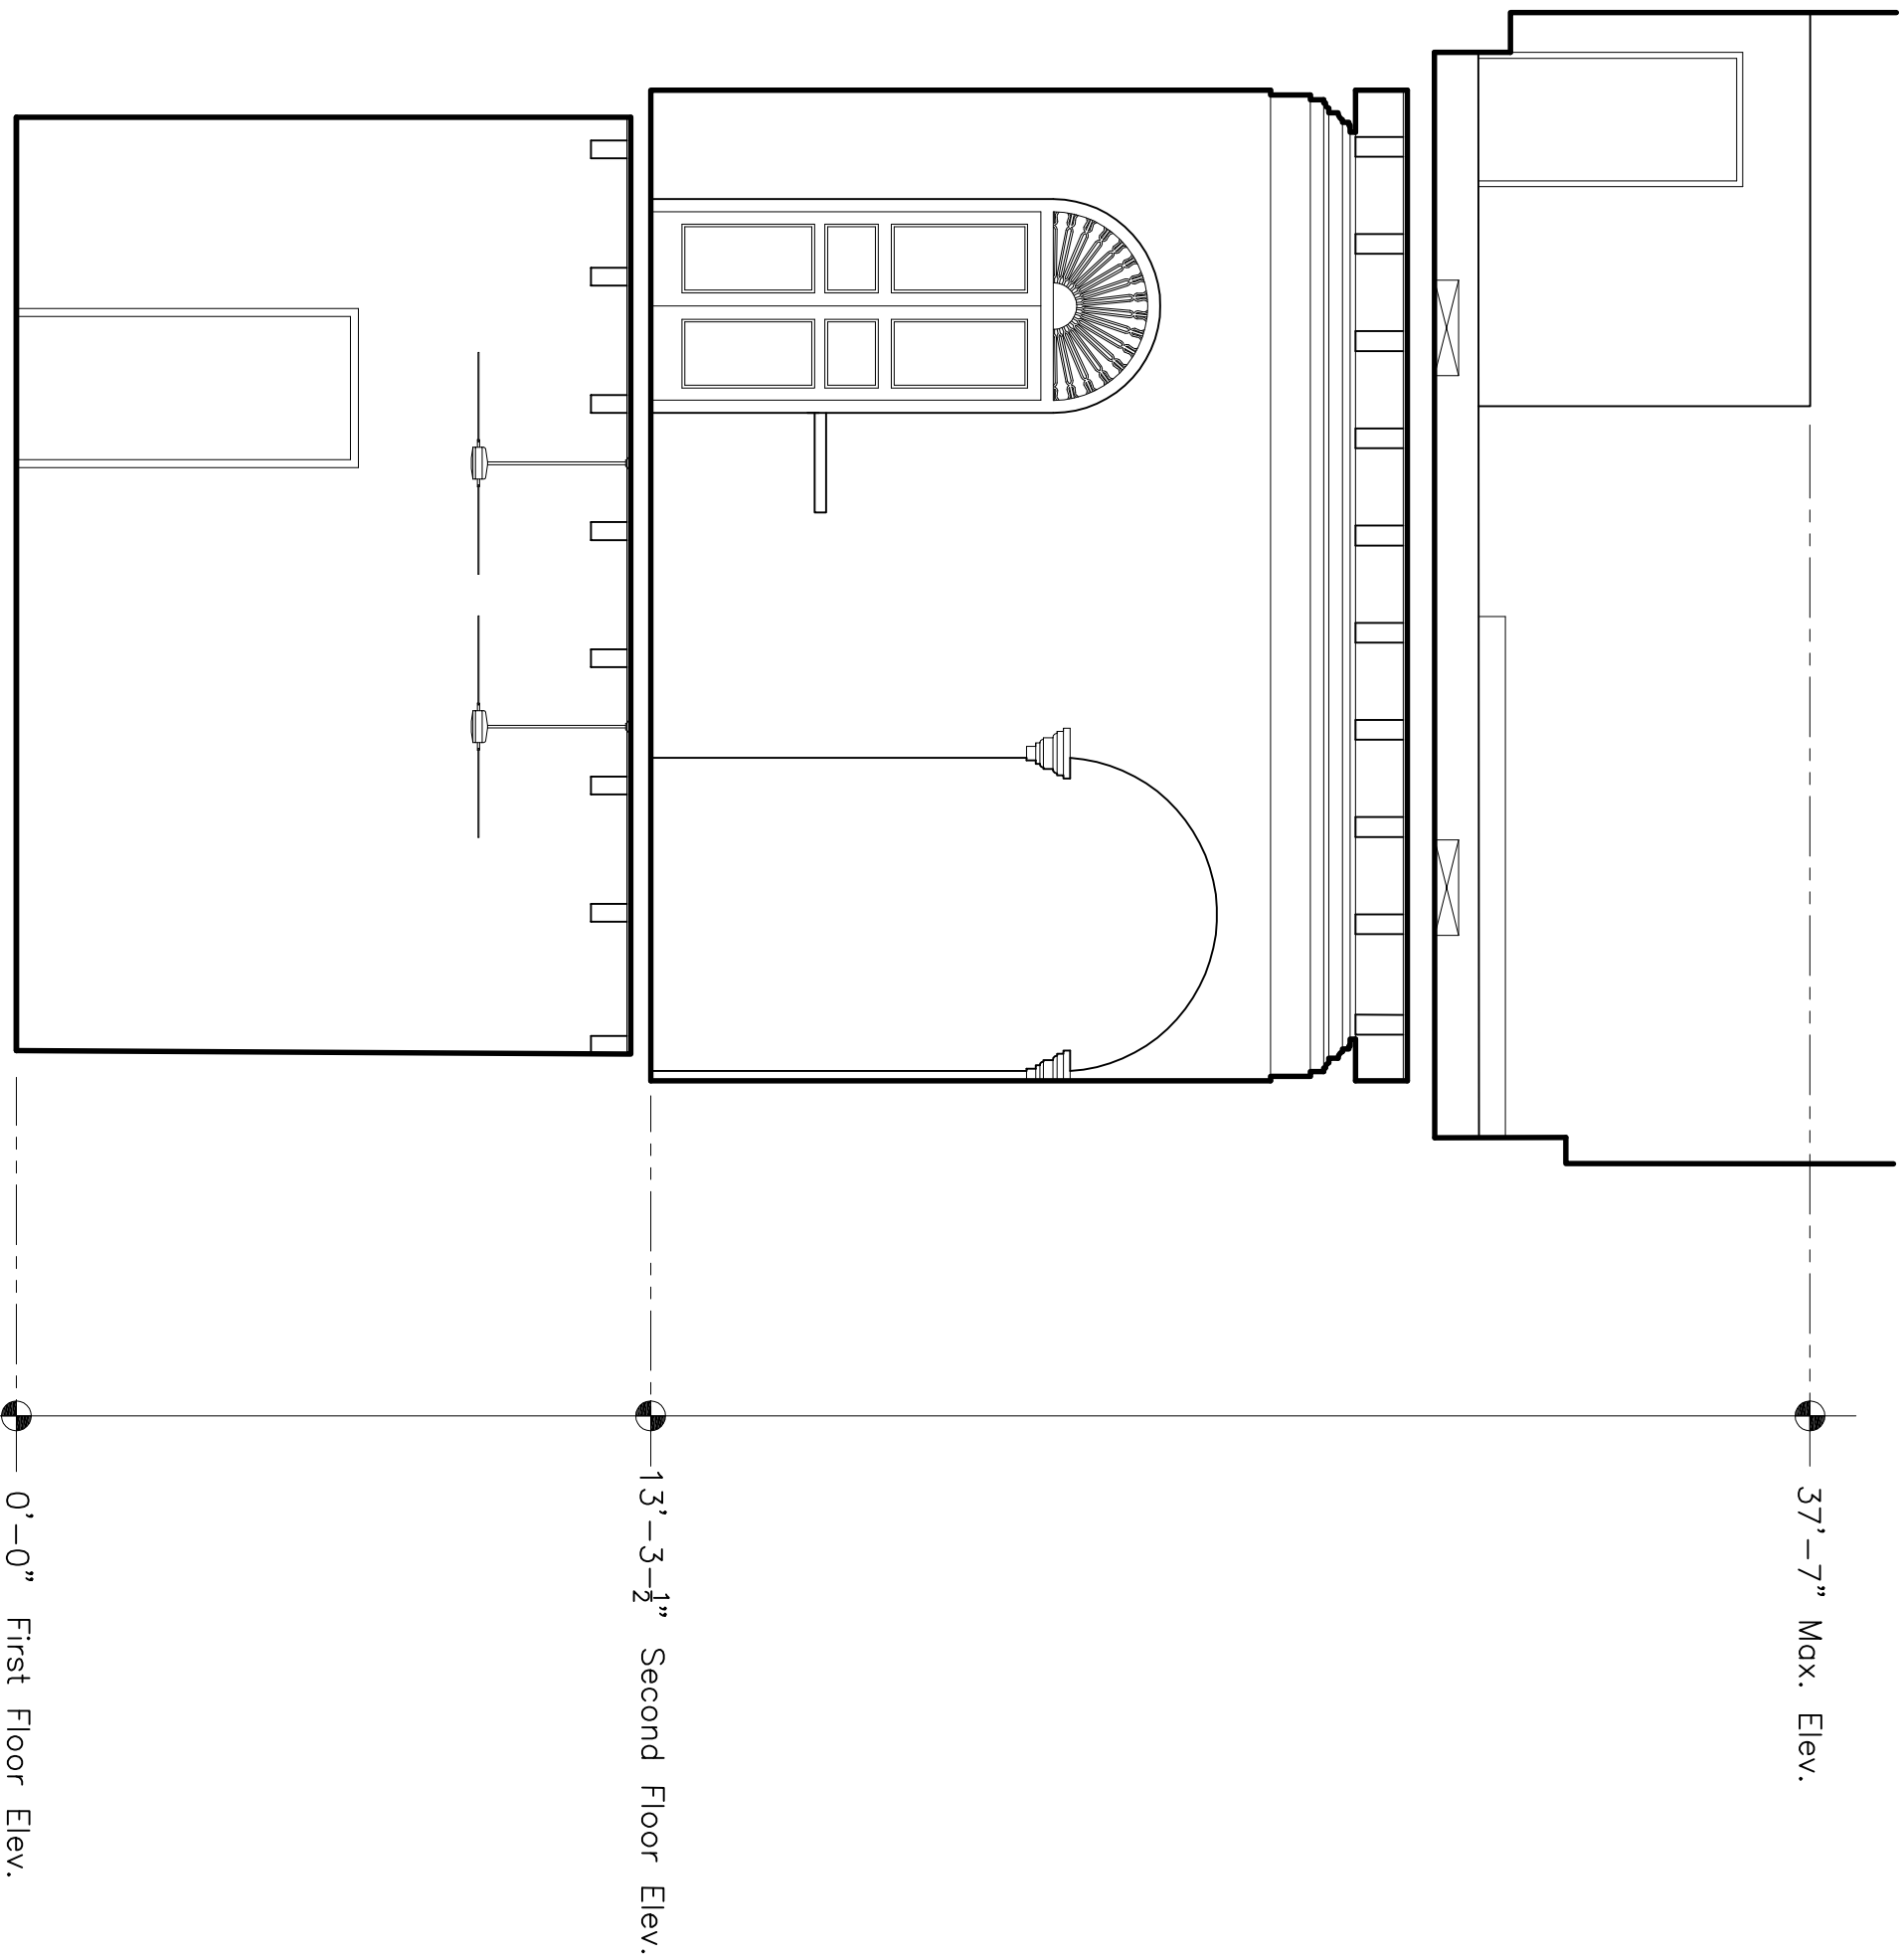

Section B-B

Scale: 1/4"=1'-0"

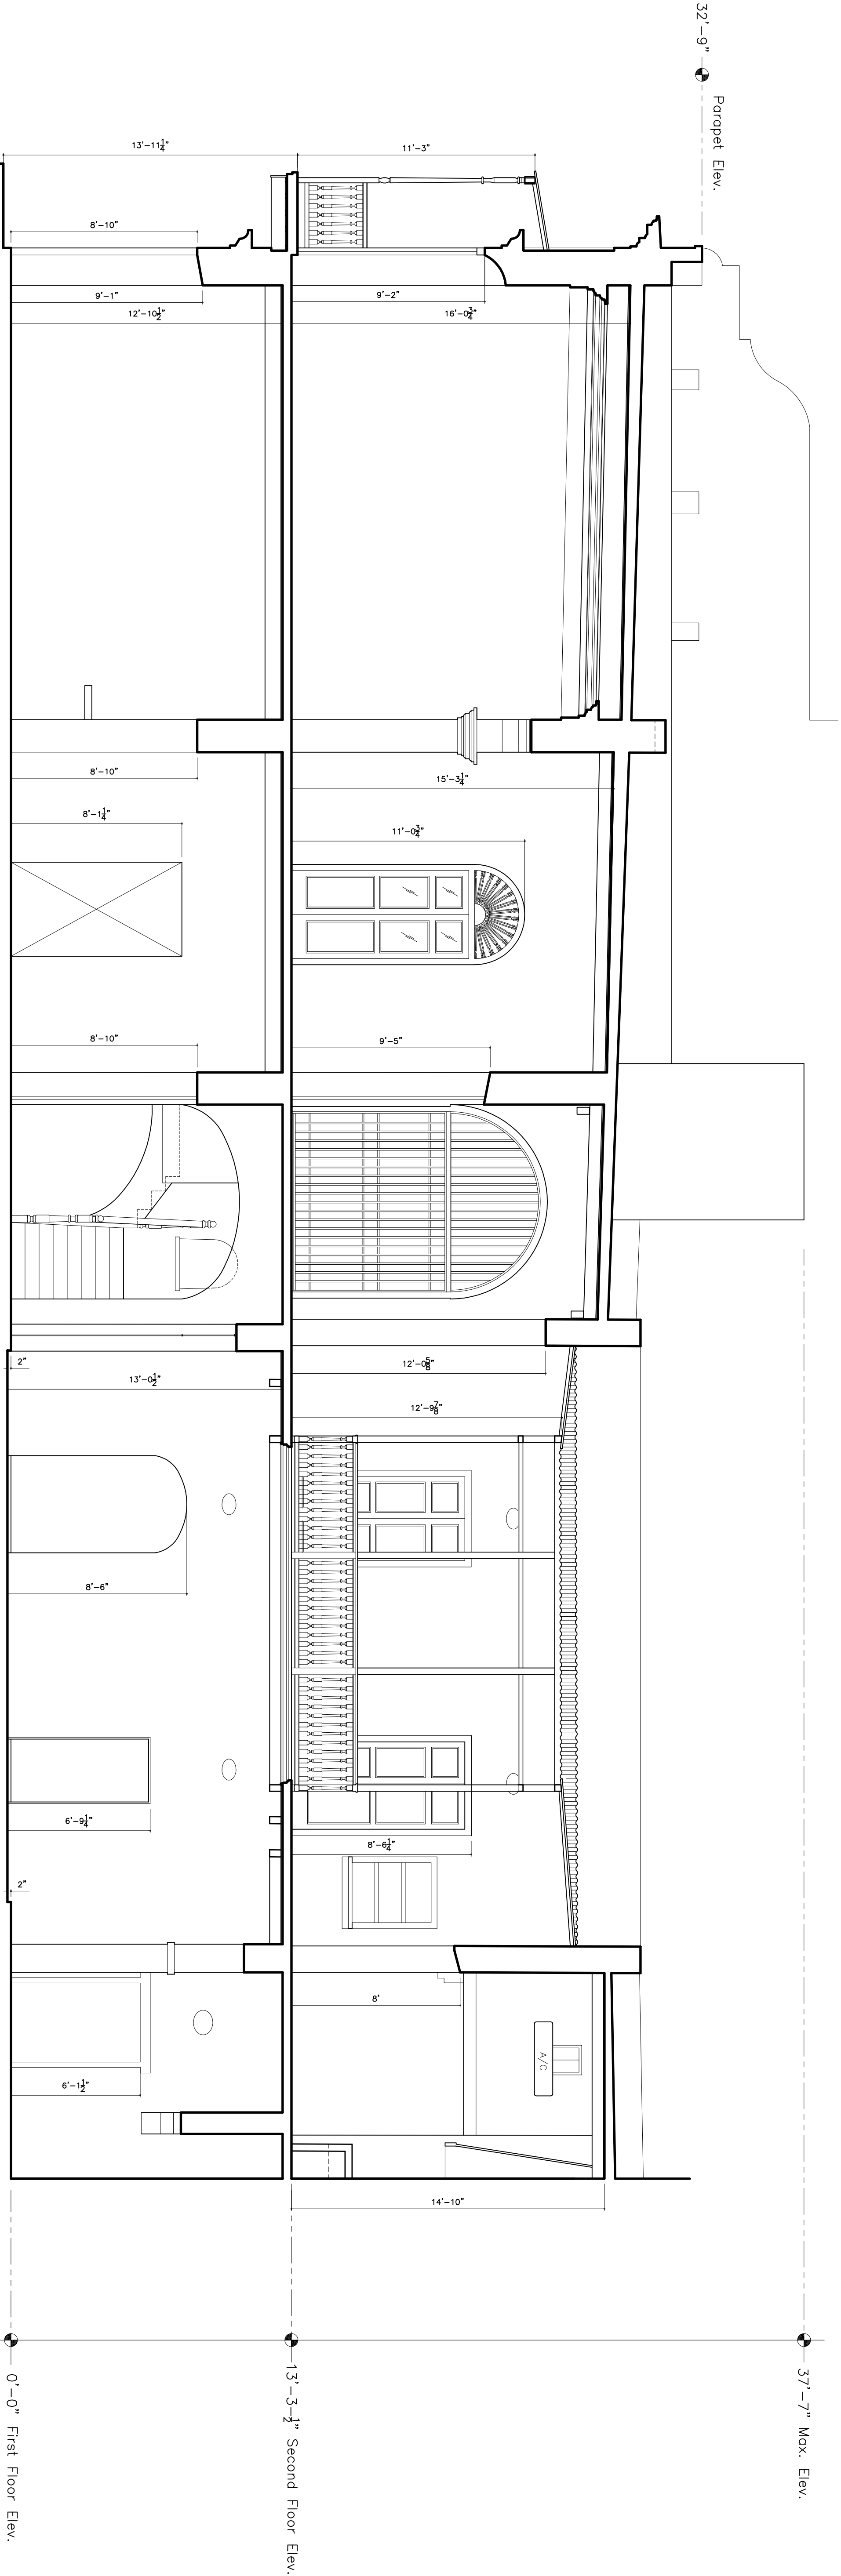

Section A-A

Scale: 1/4"=1'-0"

OWNER:

Cherif Medawar

CONSULTANTS

Arch. Rodolfo Lugo Escamilla

(107) 767-0777 / rodolfo@rpe.com

PROJECT:

#207 Del Cristo St., Old San Juan
As Built Drawings

San Juan, P.R.

REVISIONS

NO.	DATE
1	
2	
3	
4	
5	


NOTES / PERMITS

DATE: October 21, 2016

Existing
Sections
(As Built)


HOUA:

A-3

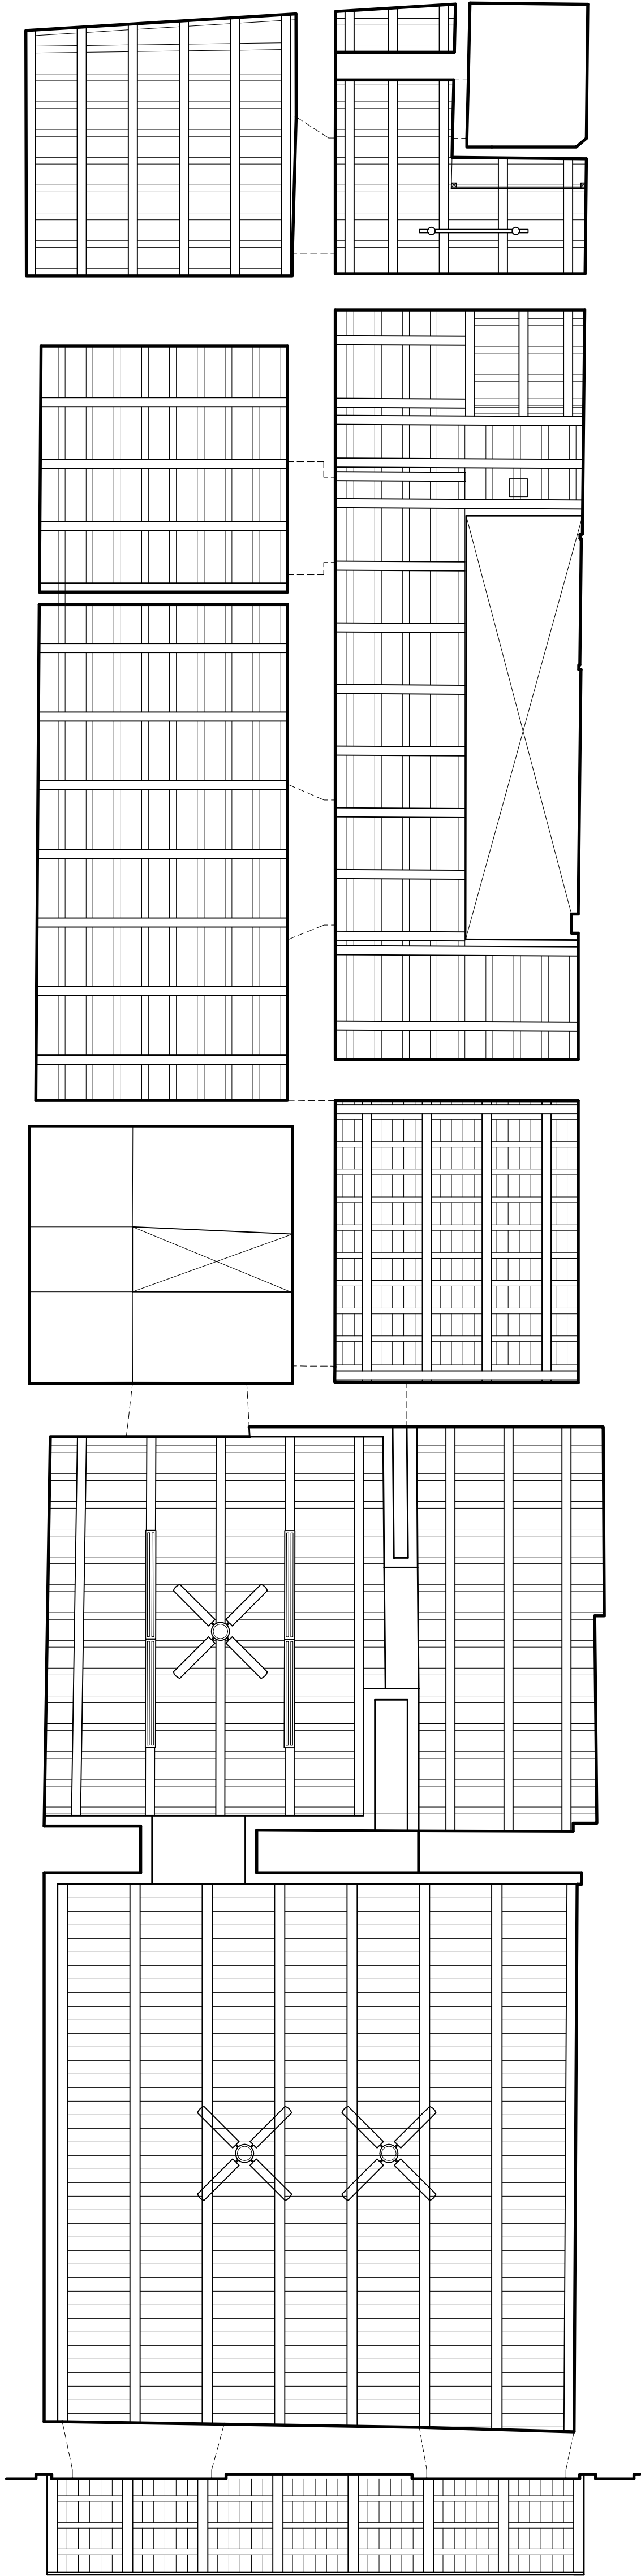


First Floor Plan
Reflected Ceiling

Scale: 1/4"=1'-0"

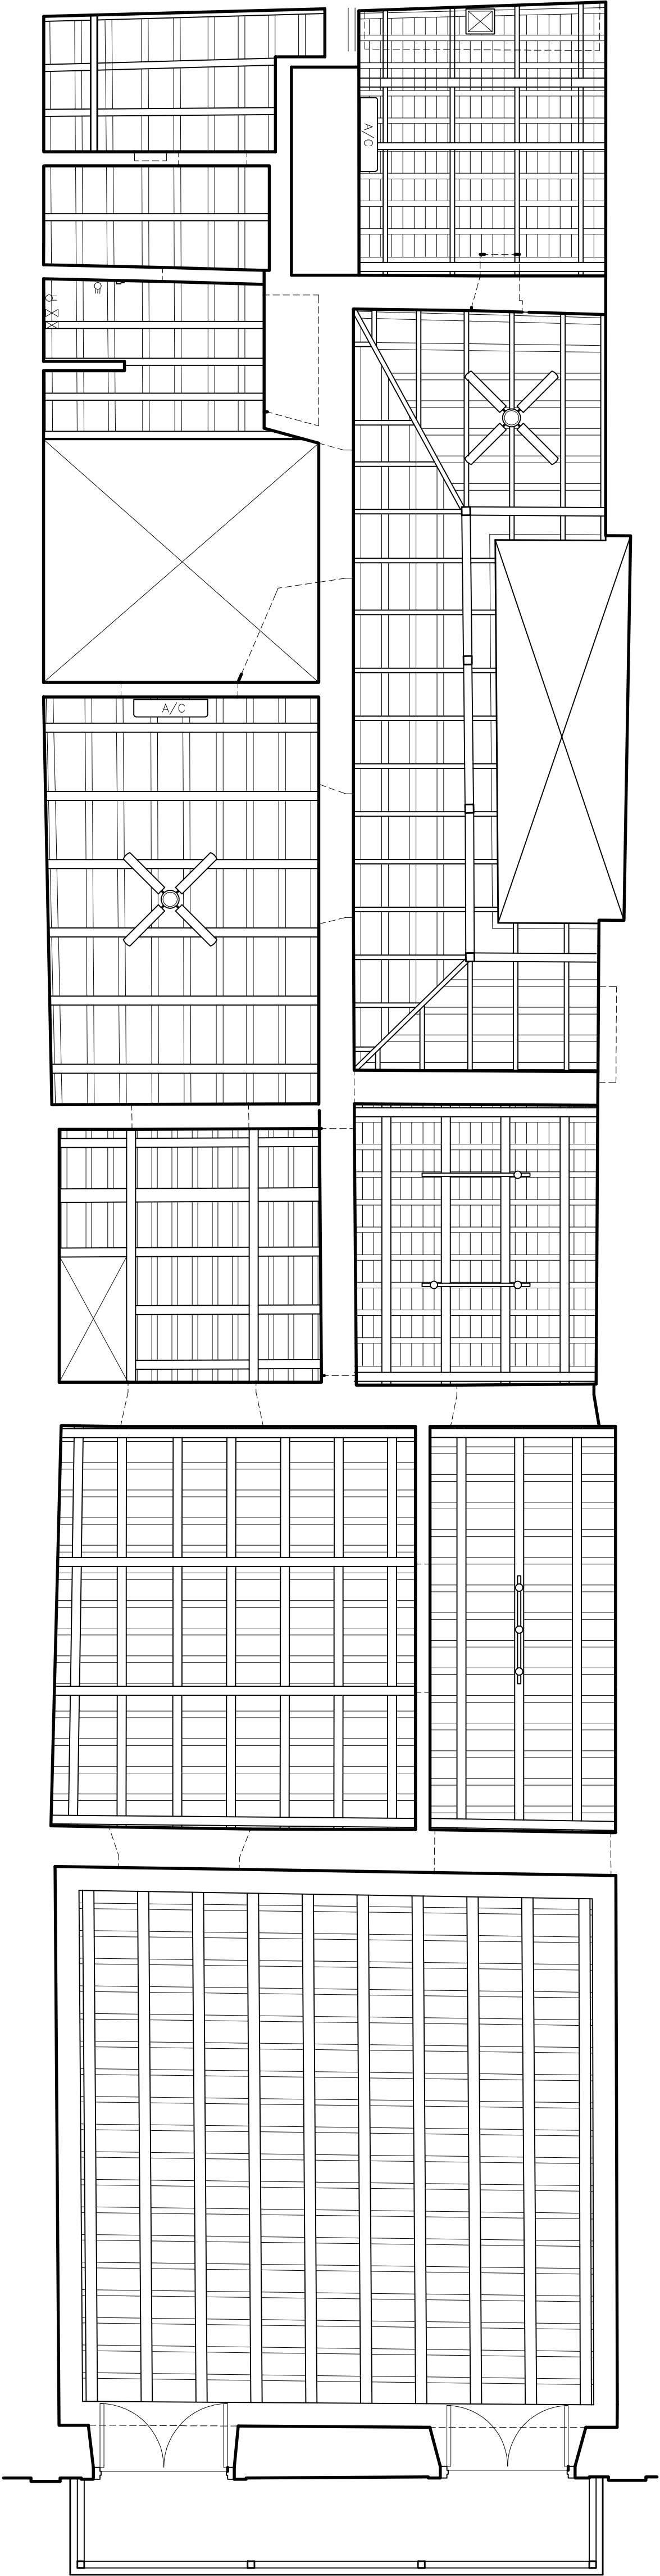

Second Floor Plan
Reflected Ceiling

Scale: 1/4"=1'-0"

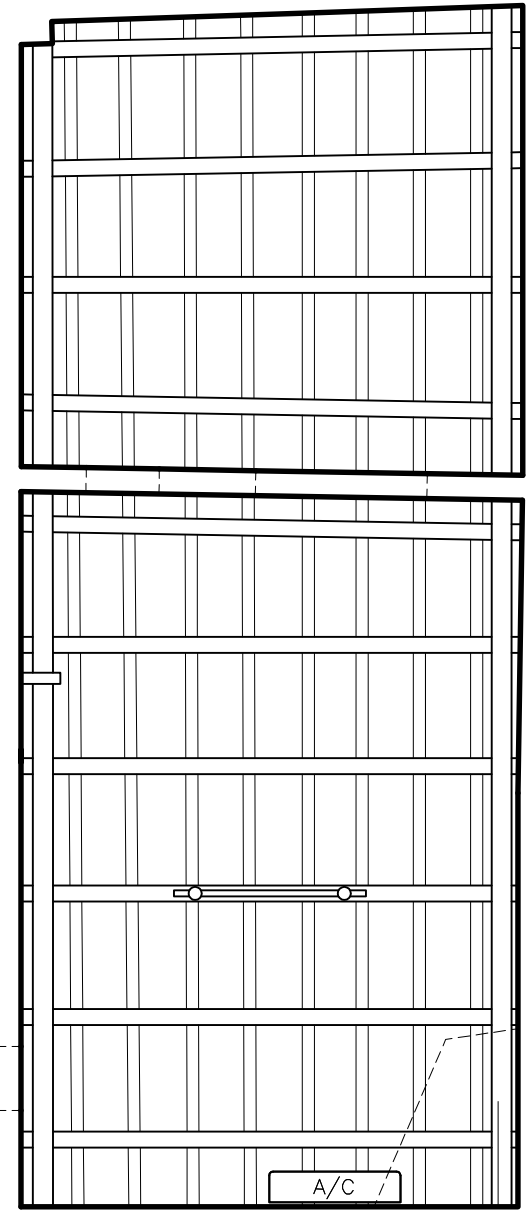

Mezzanine
Reflected Ceiling

Scale: 1/4"=1'-0"

OWNER:

Cherif Medawar

CONSULTANTS

Asa Rodenas Lago Screenfeld

(a) (b) (c) (d) (e) (f) (g) (h) (i) (j) (k) (l) (m) (n) (o) (p) (q) (r) (s) (t) (u) (v) (w) (x) (y) (z) (aa) (ab) (ac) (ad) (ae) (af) (ag) (ah) (ai) (aj) (ak) (al) (am) (an) (ao) (ap) (aq) (ar) (as) (at) (au) (av) (aw) (ax) (ay) (az) (ba) (bb) (bc) (bd) (be) (bf) (bg) (bh) (bi) (bj) (bk) (bl) (bm) (bn) (bo) (bp) (bq) (br) (bs) (bt) (bu) (bv) (bw) (bx) (by) (bz) (ca) (cb) (cc) (cd) (ce) (cf) (cg) (ch) (ci) (cj) (ck) (cl) (cm) (cn) (co) (cp) (cq) (cr) (cs) (ct) (cu) (cv) (cw) (cx) (cy) (cz) (da) (db) (dc) (dd) (de) (df) (dg) (dh) (di) (dj) (dk) (dl) (dm) (dn) (do) (dp) (dq) (dr) (ds) (dt) (du) (dv) (dw) (dx) (dy) (dz) (ea) (eb) (ec) (ed) (ee) (ef) (eg) (eh) (ei) (ej) (ek) (el) (em) (en) (eo) (ep) (eq) (er) (es) (et) (eu) (ev) (ew) (ex) (ey) (ez) (fa) (fb) (fc) (fd) (fe) (ff) (fg) (fh) (fi) (fj) (fk) (fl) (fm) (fn) (fo) (fp) (fq) (fr) (fs) (ft) (fu) (fv) (fw) (fx) (fy) (fz) (ga) (gb) (gc) (gd) (ge) (gf) (gg) (gh) (gi) (gj) (gk) (gl) (gm) (gn) (go) (gp) (gq) (gr) (gs) (gt) (gu) (gv) (gw) (gx) (gy) (gz) (ha) (hb) (hc) (hd) (he) (hf) (hg) (hh) (hi) (hj) (hk) (hl) (hm) (hn) (ho) (hp) (hq) (hr) (hs) (ht) (hu) (hv) (hw) (hx) (hy) (hz) (ia) (ib) (ic) (id) (ie) (if) (ig) (ih) (ii) (ij) (ik) (il) (im) (in) (io) (ip) (iq) (ir) (is) (it) (iu) (iv) (iw) (ix) (iy) (iz) (ja) (jb) (jc) (jd) (je) (jf) (jg) (jh) (ji) (jj) (jk) (jl) (jm) (jn) (jo) (jp) (jq) (jr) (js) (jt) (ju) (jv) (jw) (jx) (jy) (jz) (ka) (kb) (kc) (kd) (ke) (kf) (kg) (kh) (ki) (kj) (kk) (kl) (km) (kn) (ko) (kp) (kq) (kr) (ks) (kt) (ku) (kv) (kw) (kx) (ky) (kz) (la) (lb) (lc) (ld) (le) (lf) (lg) (lh) (li) (lj) (lk) (ll) (lm) (ln) (lo) (lp) (lq) (lr) (ls) (lt) (lu) (lv) (lw) (lx) (ly) (lz) (ma) (mb) (mc) (md) (me) (mf) (mg) (mh) (mi) (mj) (mk) (ml) (mm) (mn) (mo) (mp) (mq) (mr) (ms) (mt) (mu) (mv) (mw) (mx) (my) (mz) (na) (nb) (nc) (nd) (ne) (nf) (ng) (nh) (ni) (nj) (nk) (nl) (nm) (nn) (no) (np) (nq) (nr) (ns) (nt) (nu) (nv) (nw) (nx) (ny) (nz) (oa) (ob) (oc) (od) (oe) (of) (og) (oh) (oi) (oj) (ok) (ol) (om) (on) (oo) (op) (oq) (or) (os) (ot) (ou) (ov) (ow) (ox) (oy) (oz) (pa) (pb) (pc) (pd) (pe) (pf) (pg) (ph) (pi) (pj) (pk) (pl) (pm) (pn) (po) (pp) (pq) (pr) (ps) (pt) (pu) (pv) (pw) (px) (py) (pz) (qa) (qb) (qc) (qd) (qe) (qf) (qg) (qh) (qi) (qj) (qk) (ql) (qm) (qn) (qo) (qp) (qq) (qr) (qs) (qt) (qu) (qv) (qw) (qx) (qy) (qz) (ra) (rb) (rc) (rd) (re) (rf) (rg) (rh) (ri) (rj) (rk) (rl) (rm) (rn) (ro) (rp) (rq) (rr) (rs) (rt) (ru) (rv) (rw) (rx) (ry) (rz) (sa) (sb) (sc) (sd) (se) (sf) (sg) (sh) (si) (sj) (sk) (sl) (sm) (sn) (so) (sp) (sq) (sr) (ss) (st) (su) (sv) (sw) (sx) (sy) (sz) (ta) (tb) (tc) (td) (te) (tf) (tg) (th) (ti) (tj) (tk) (tl) (tm) (tn) (to) (tp) (tq) (tr) (ts) (tt) (tu) (tv) (tw) (tx) (ty) (tz) (ua) (ub) (uc) (ud) (ue) (uf) (ug) (uh) (ui) (uj) (uk) (ul) (um) (un) (uo) (up) (uq) (ur) (us) (ut) (uu) (uv) (uw) (ux) (uy) (uz) (va) (vb) (vc) (vd) (ve) (vf) (vg) (vh) (vi) (vj) (vk) (vl) (vm) (vn) (vo) (vp) (vq) (vr) (vs) (vt) (vu) (vv) (vw) (vx) (vy) (vz) (wa) (wb) (wc) (wd) (we) (wf) (wg) (wh) (wi) (wj) (wk) (wl) (wm) (wn) (wo) (wp) (wq) (wr) (ws) (wt) (wu) (wv) (ww) (wx) (wy) (wz) (xa) (xb) (xc) (xd) (xe) (xf) (xg) (xh) (xi) (xj) (xk) (xl) (xm) (xn) (xo) (xp) (xq) (xr) (xs) (xt) (xu) (xv) (xw) (xx) (xy) (xz) (ya) (yb) (yc) (yd) (ye) (yf) (yg) (yh) (yi) (yj) (yk) (yl) (ym) (yn) (yo) (yp) (yq) (yr) (ys) (yt) (yu) (yv) (yw) (yx) (yy) (yz) (za) (zb) (zc) (zd) (ze) (zf) (zg) (zh) (zi) (zj) (zk) (zl) (zm) (zn) (zo) (zp) (zq) (zr) (zs) (zt) (zu) (zv) (zw) (zx) (zy) (zz)

PROJECT:

#207 Del Cristo St., Old San Juan
As Built Drawings
San Juan, P.R.

REVISIONS

NO.	DATE
1	
2	
3	
4	
5	

NOTES / PERMITS

DATE: October 18, 2016

Existing
Rfl. Ceiling
(As Built)

HOTAS: