



Second Floor Plan

Scale: 1/4"=1'-0"
 Net Area: 2,486.2 SF
 Gross Area: 2,803.25 SF

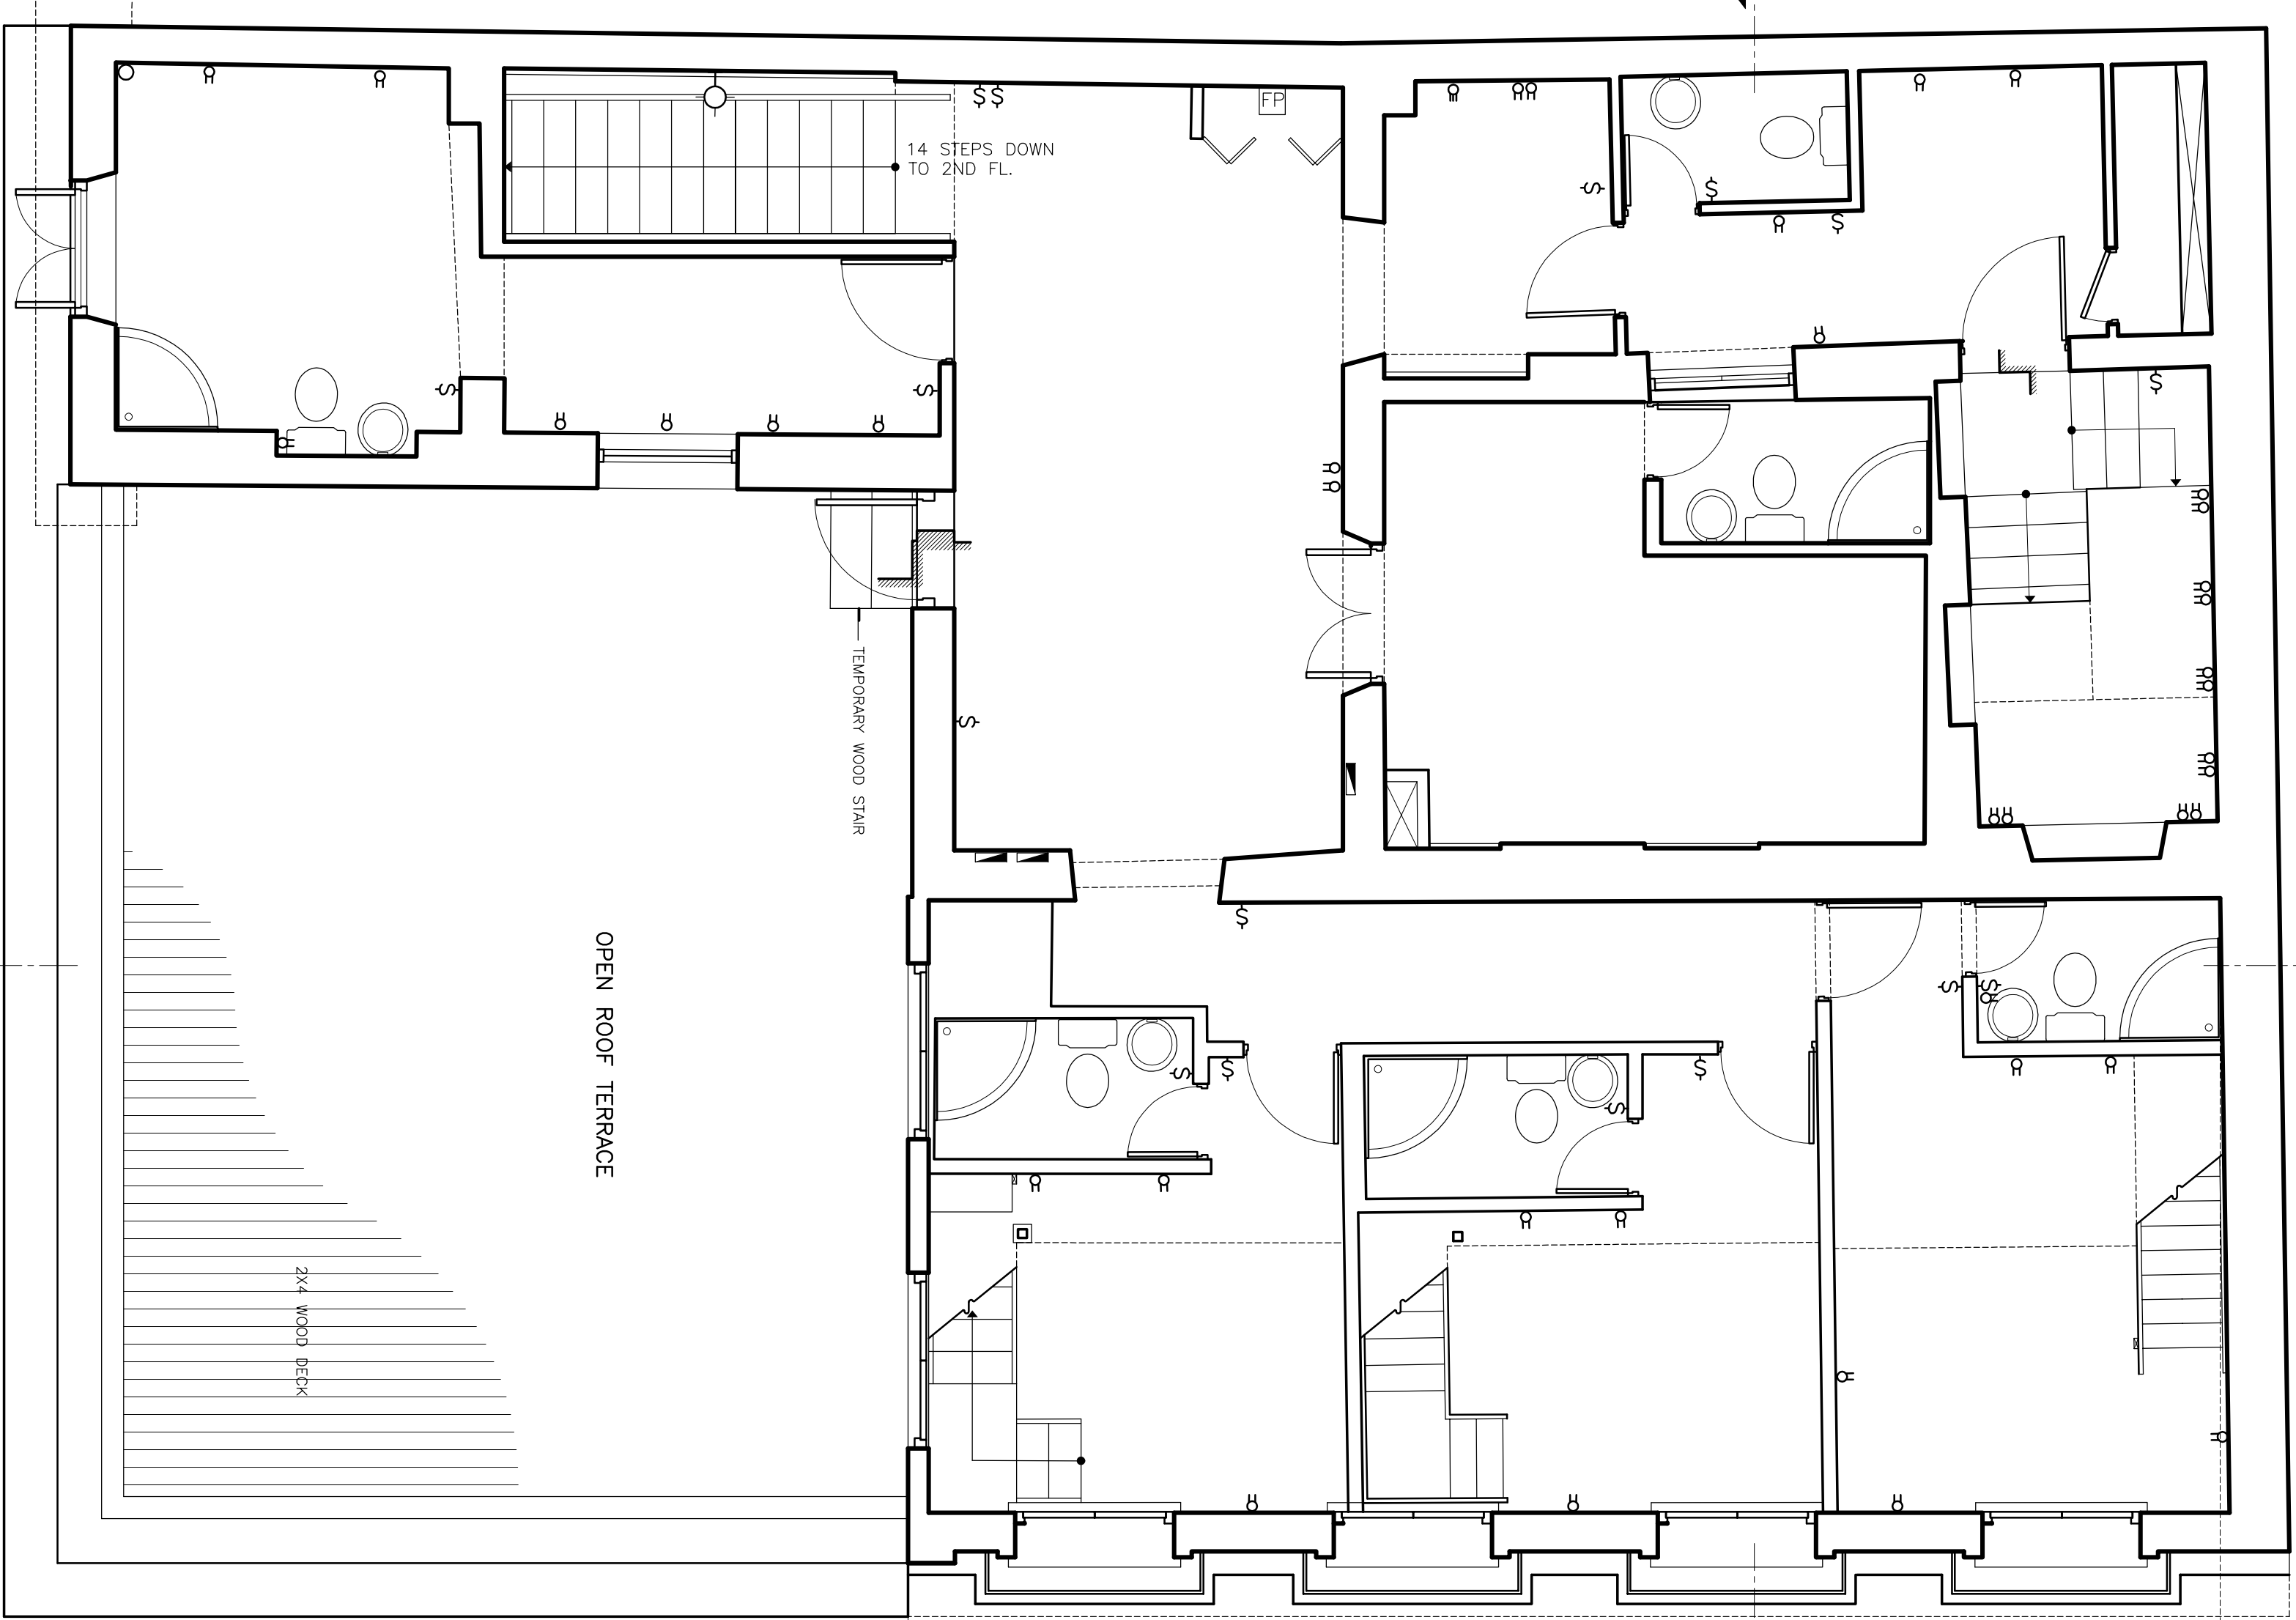


Third Floor Plan

Scale: 1/4"=1'-0"
 Net Area: 2,438.8 SF
 Gross Area: 2,788.5 SF

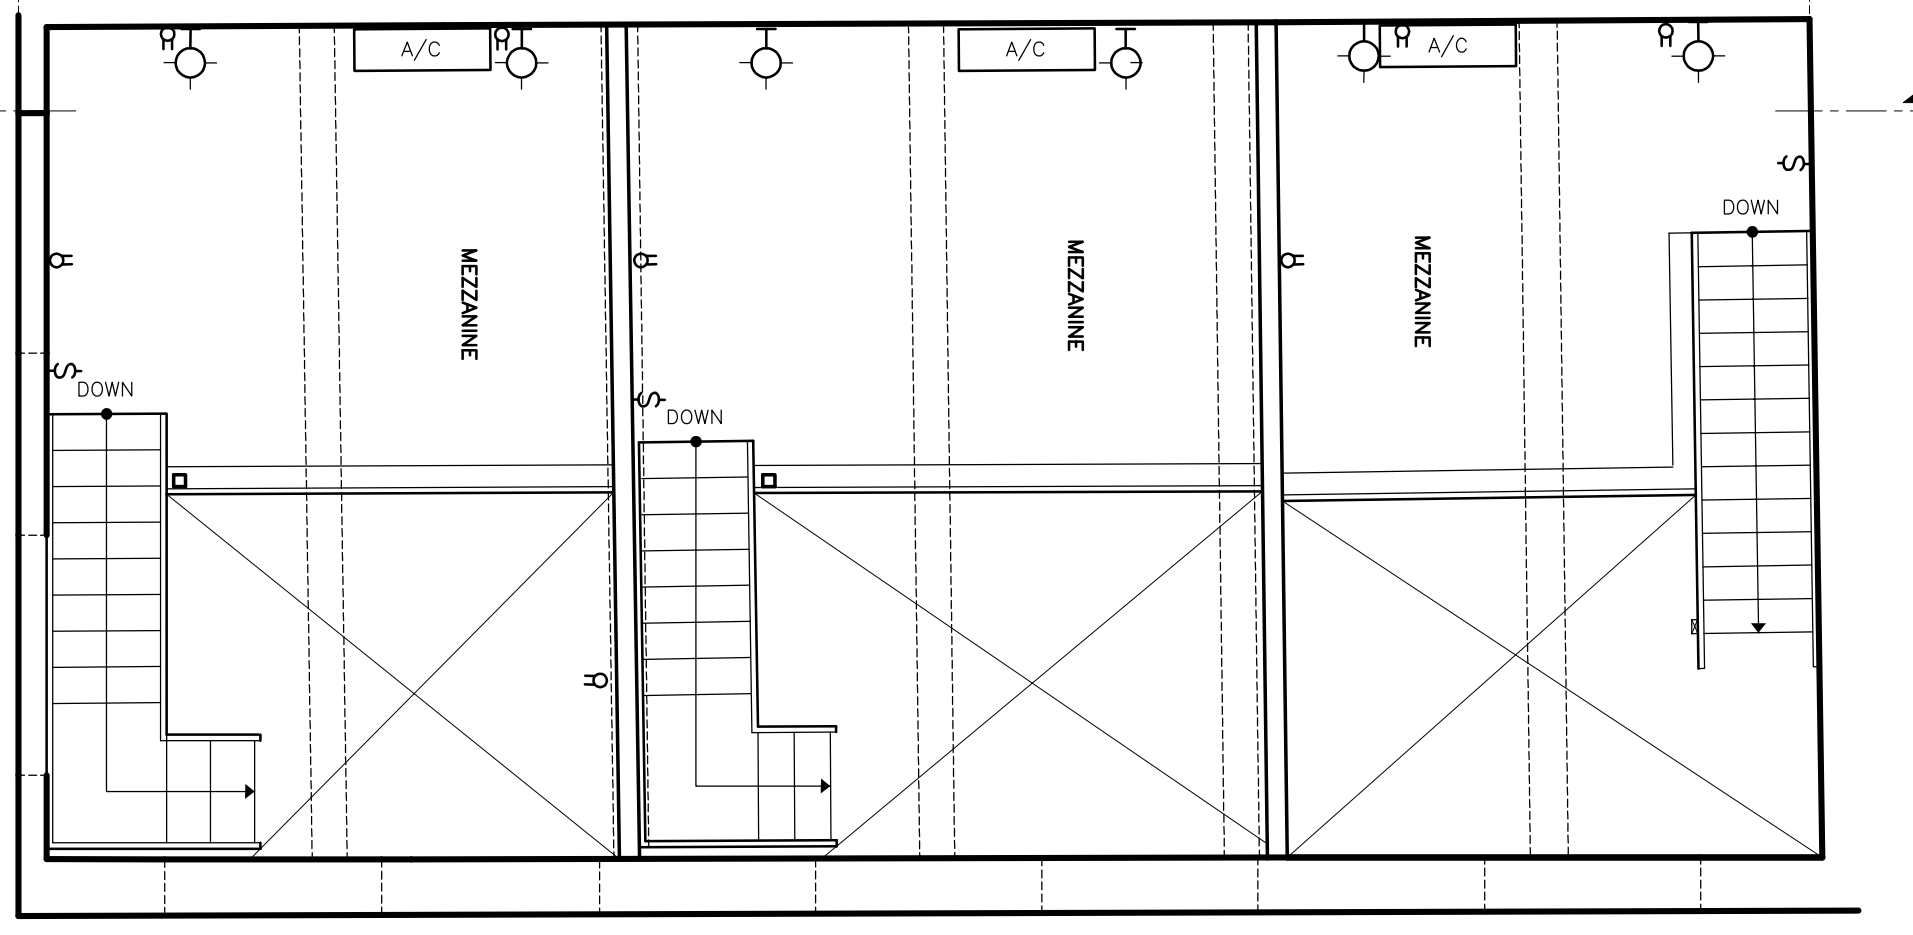


Second Floor Plan (Mezzanines)

Scale: 1/4"=1'-0"
 Net Area: 337 SF

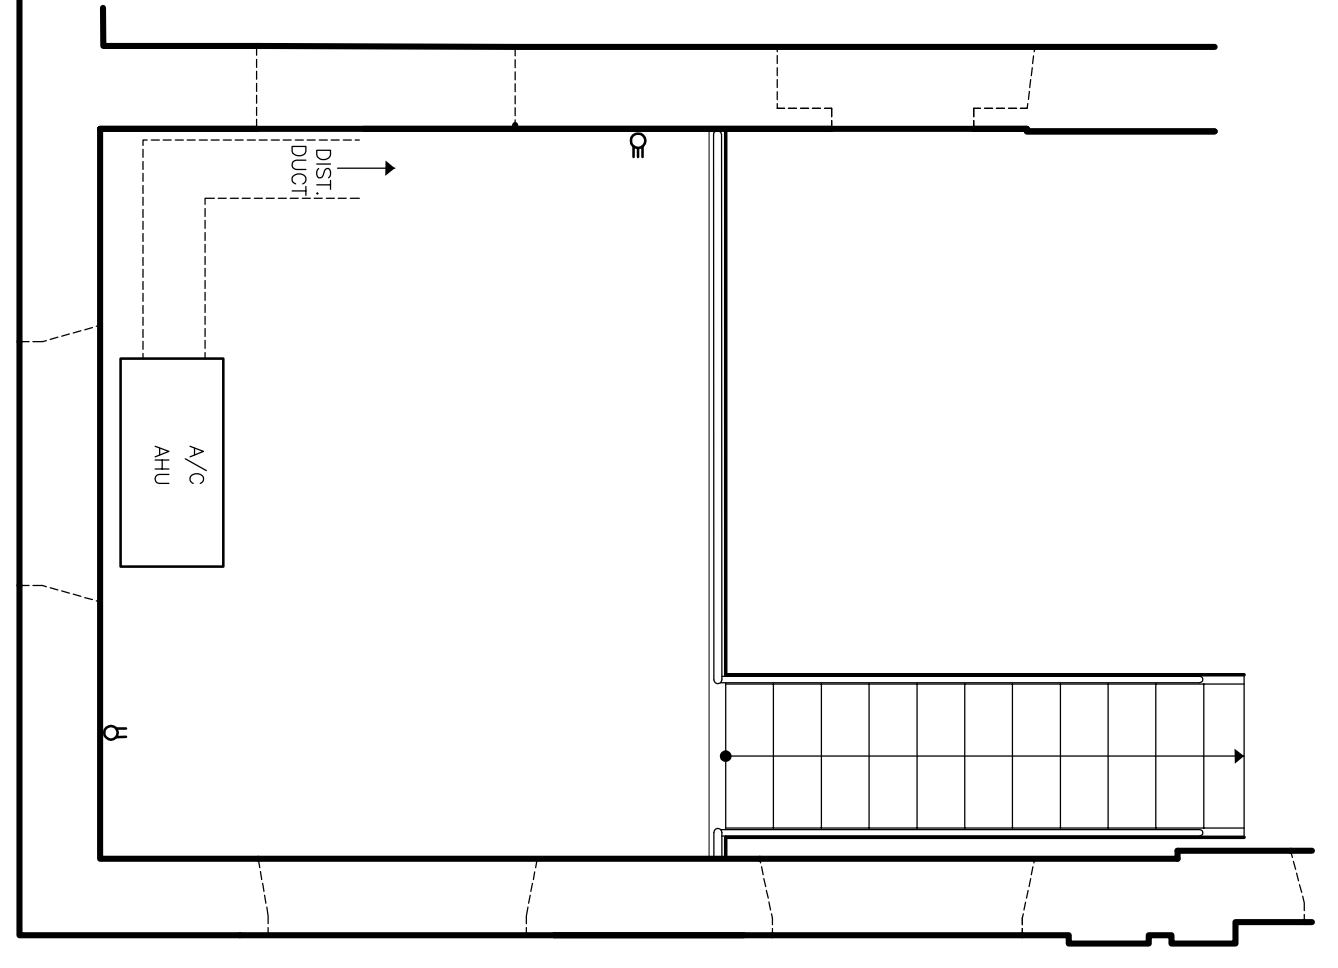

Main Mezzanine Floor Plan

Scale: 1/4"=1'-0"
 Net Area: 193 SF

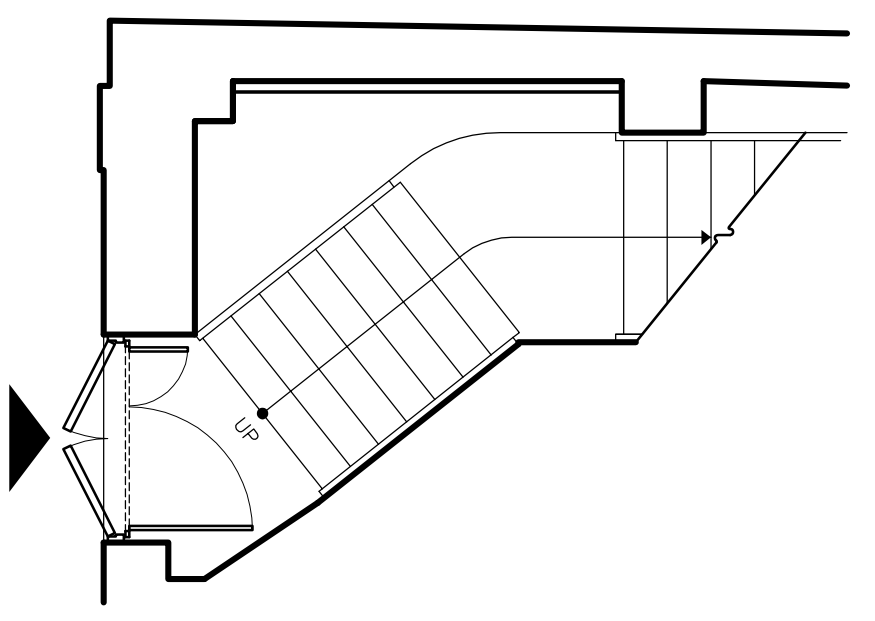

San Justo St Entrance

Scale: 1/4"=1'-0"
 Net Area: 71.75 SF
 Gross Area: 100 SF

OWNER:
 Mr. Cherril Meddowar

CONSULTANTS

Arq. Rodenas Lugo Esquivel
 (787) 362-7133 / rodenas@esquivel-arq.com

PROJECT:

#209 San Justo St., Old San Juan
 As Built Drawings (2nd. & 3rd. Fl.)
 San Juan, P.R.

REVISIONS

NO.	DATE
1	
2	
3	
4	
5	

NOTES / PERMITS

DATE: June 22, 2019

2nd. Fl. Plan,
 3rd. Fl. Plan,
 Mezzanines &
 San Justo St.
 Entrance

H01A:
AB-1