

OWNER:  
Mr. Cheff Meddwar

CONSULTANTS  
Arq. Rodenas Ugo Eschenwald  
(973) 262-7133 / eschenwald@arquero.com

PROJECT:

**#209 San Justo St., Old San Juan**  
As Built Drawings (2nd. & 3rd. Fl.)  
San Juan, P.R.

NO.	REVISIONS	DATE
1		
2		
3		
4		
5		


NOTES / PERMITS

DATE: June 22, 2019

Tile Sheet

H01A:

AS-3

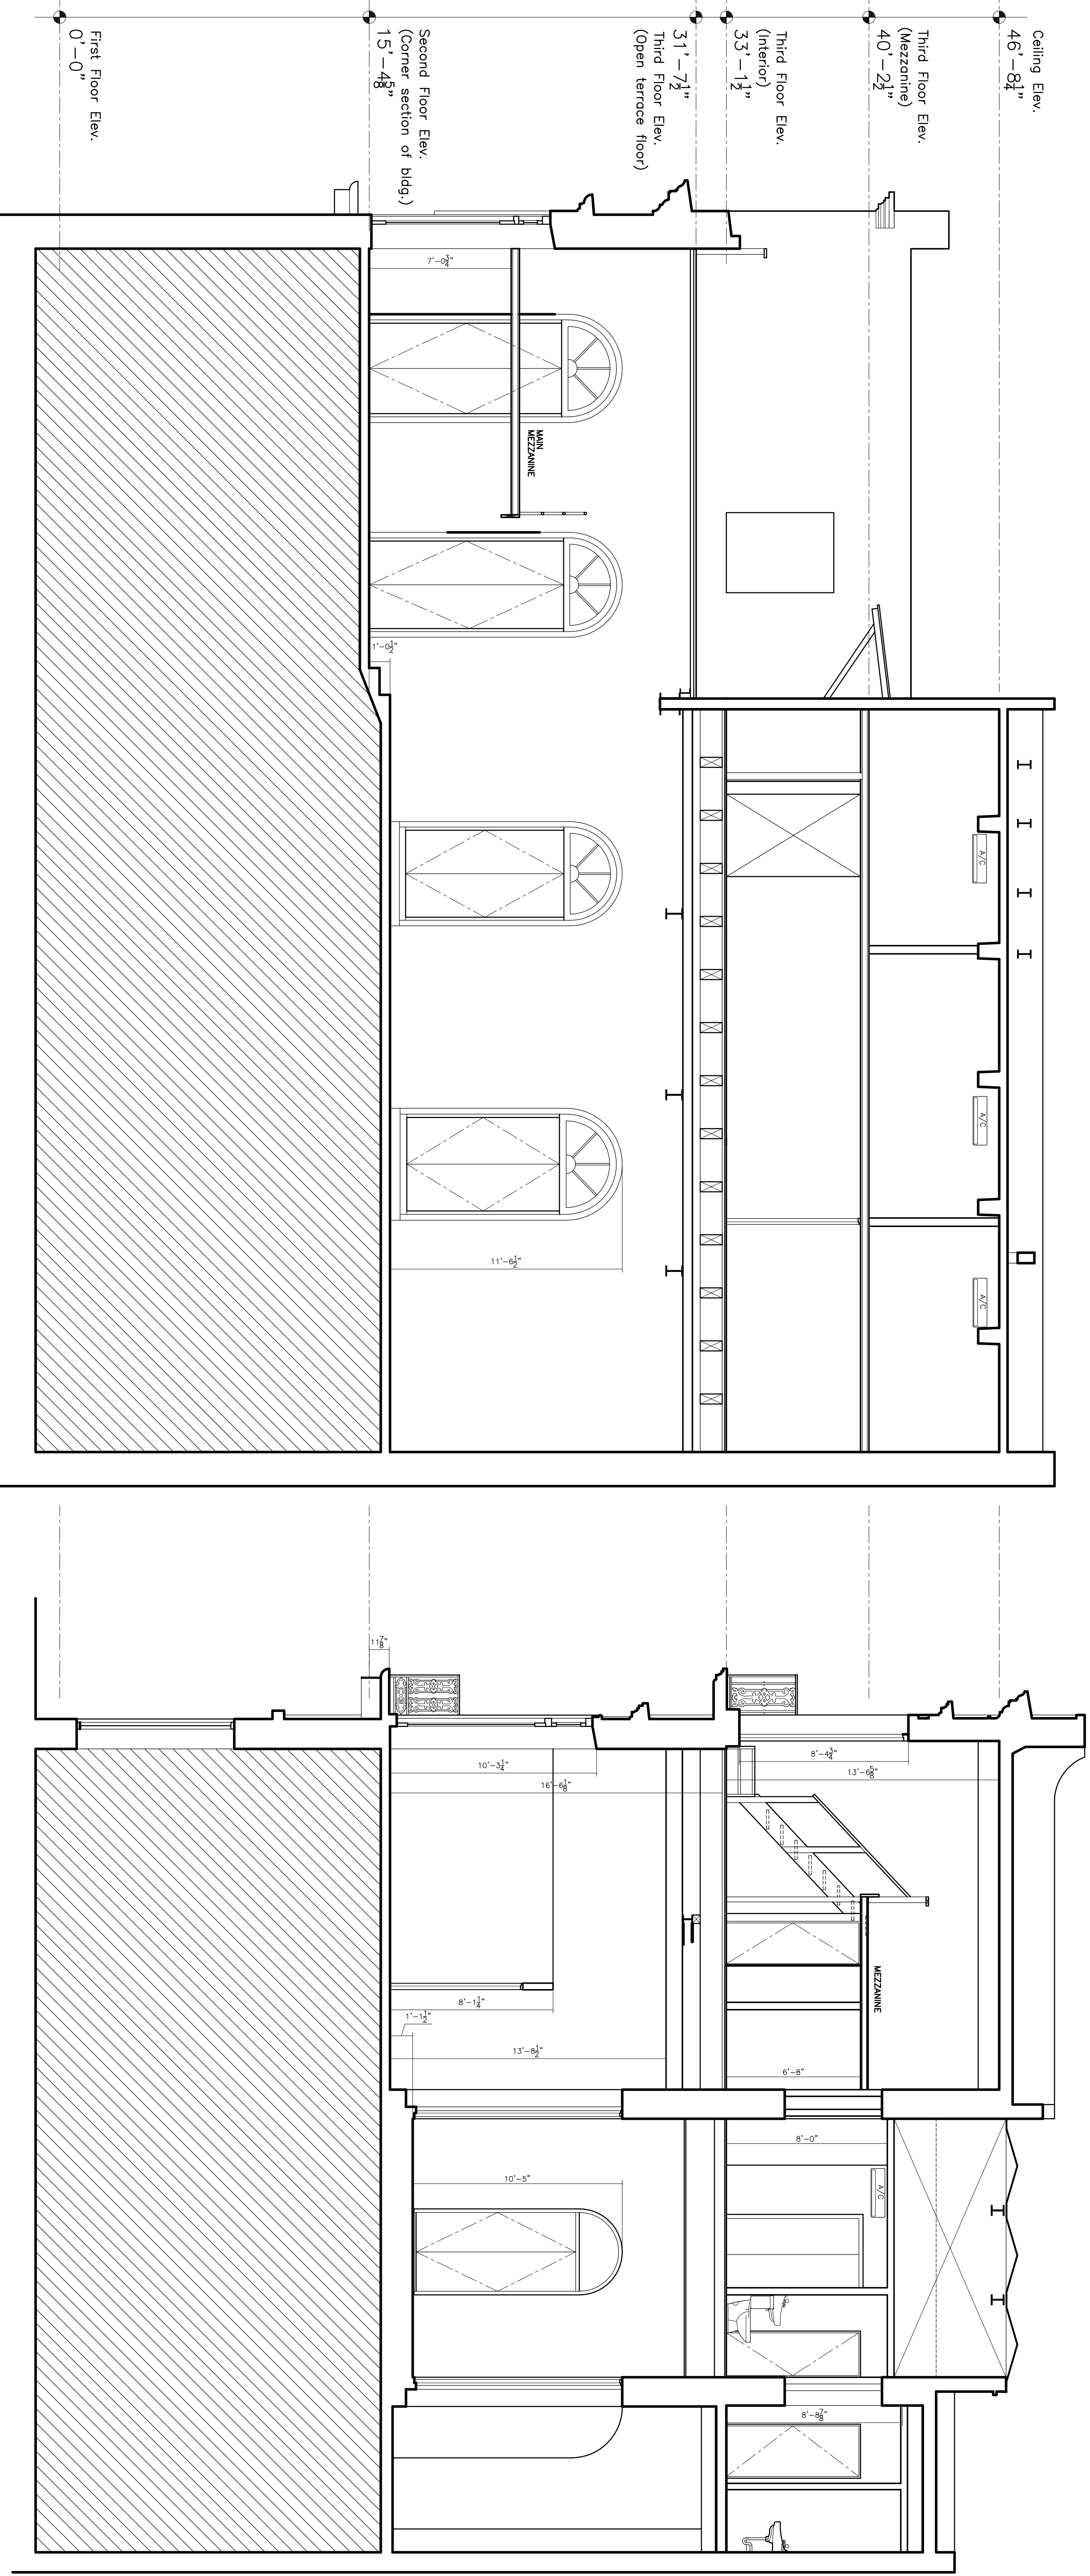

Longitudinal Section  
Scale: 1/4"=1'-0"

Longitudinal Section  
Scale: 1/4"=1'-0"