





USGS Quadrangle Map (Nad83 X:233688.8367, Y:269933.0585)

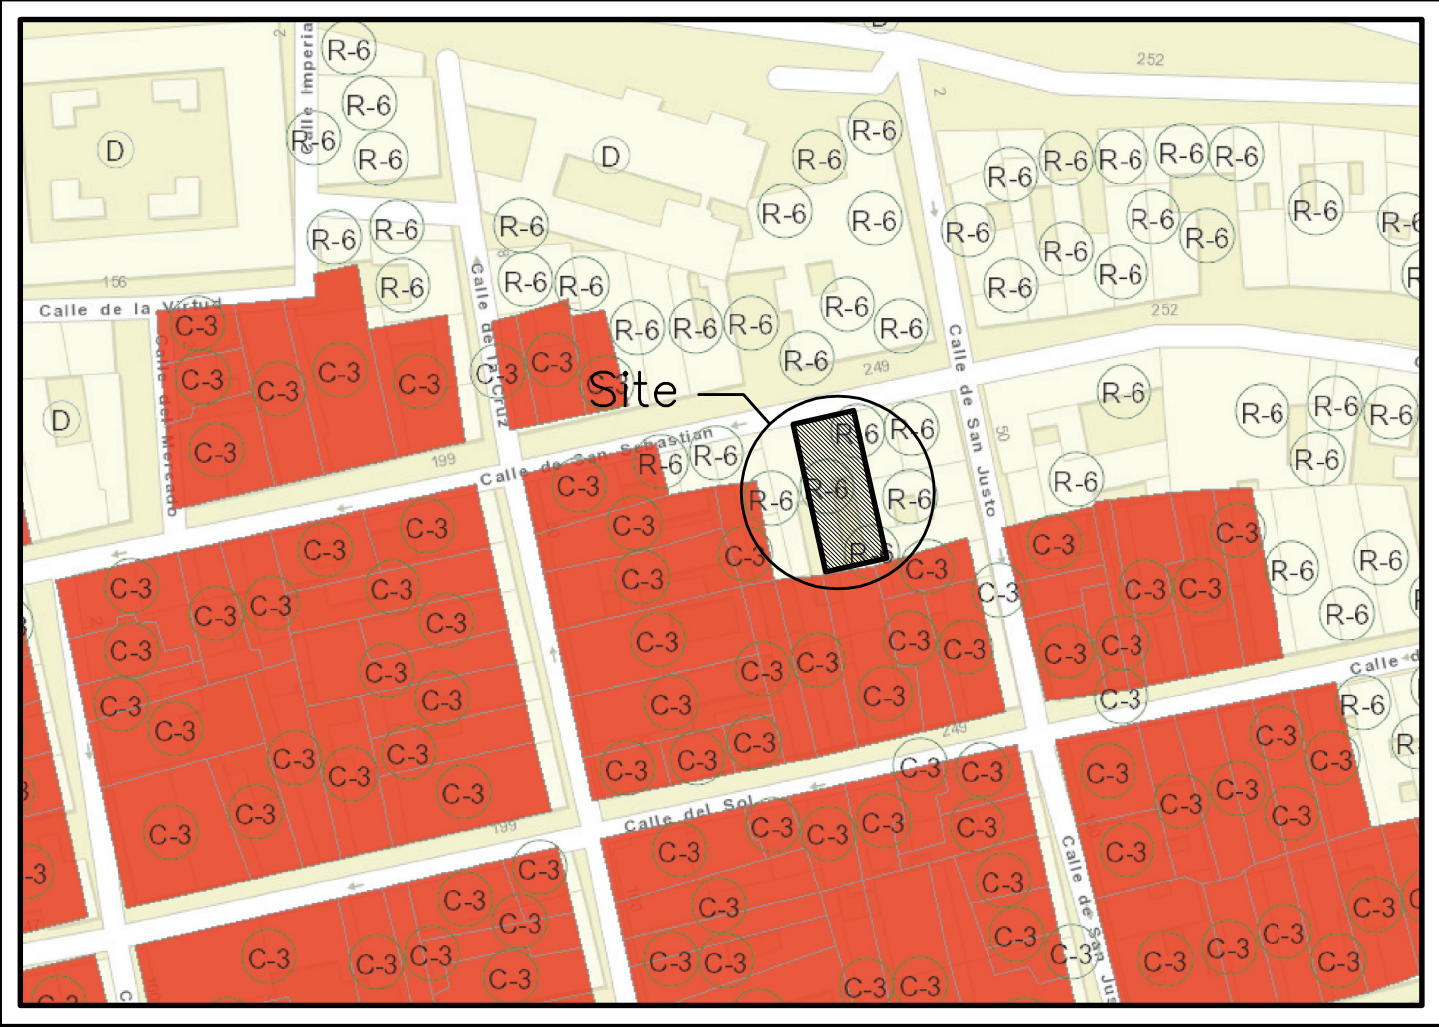

Zoning Map (Sheet 3D and 3E / August 4, 2013 and March 2, 2014)

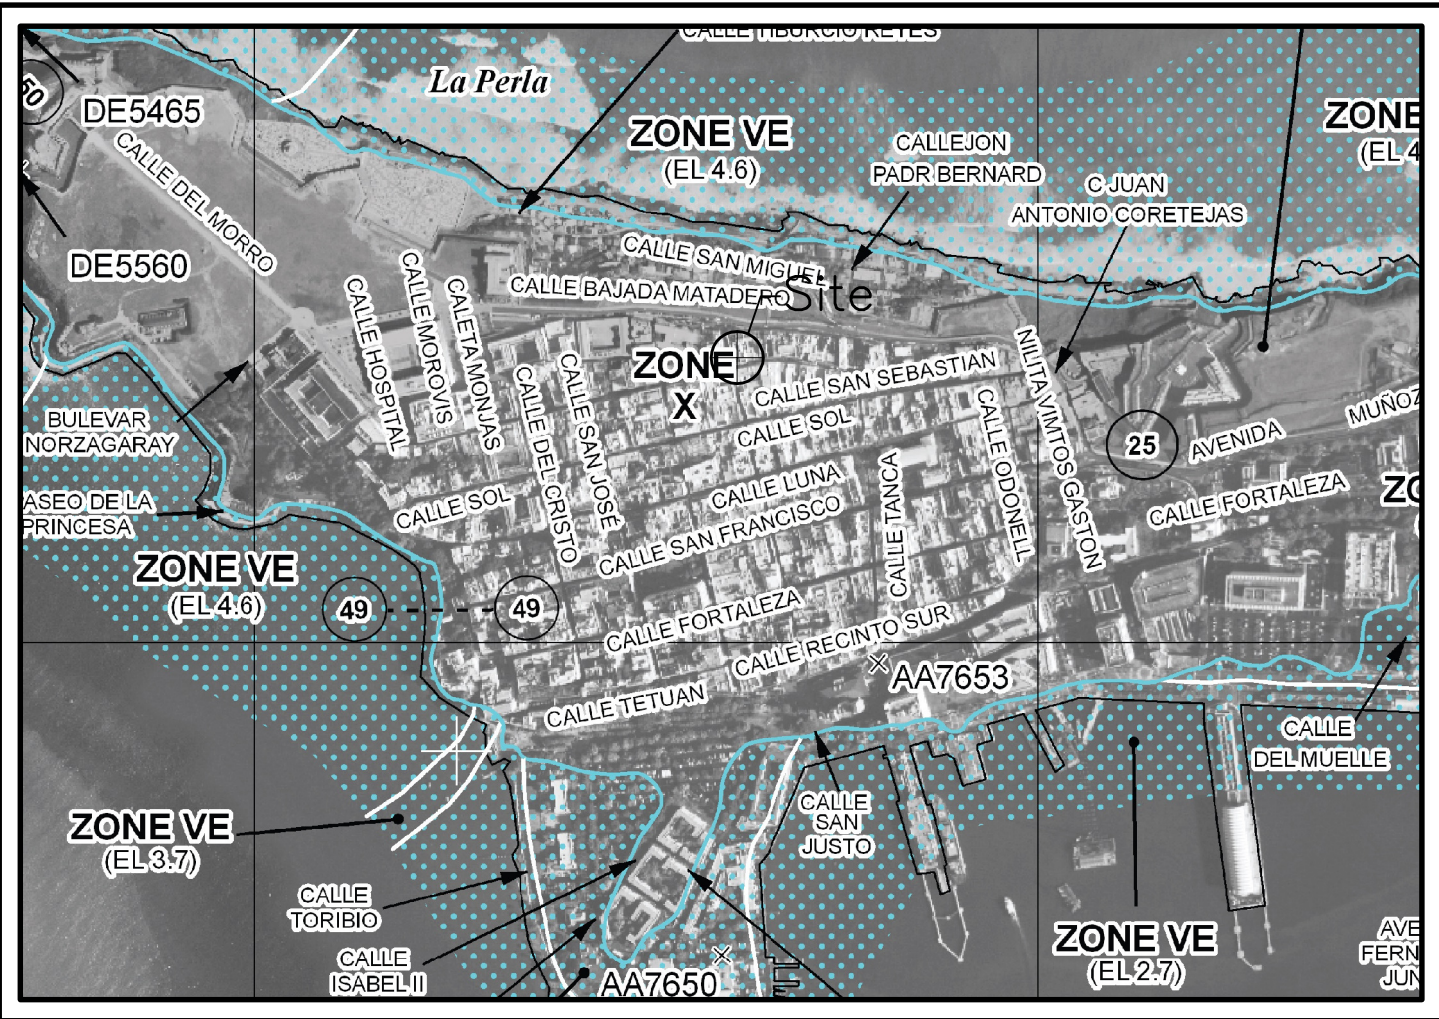


Flood Map (C0007C0355J) November, 18, 2009




Front Elevation

Scale: 1/4"=1'-0"

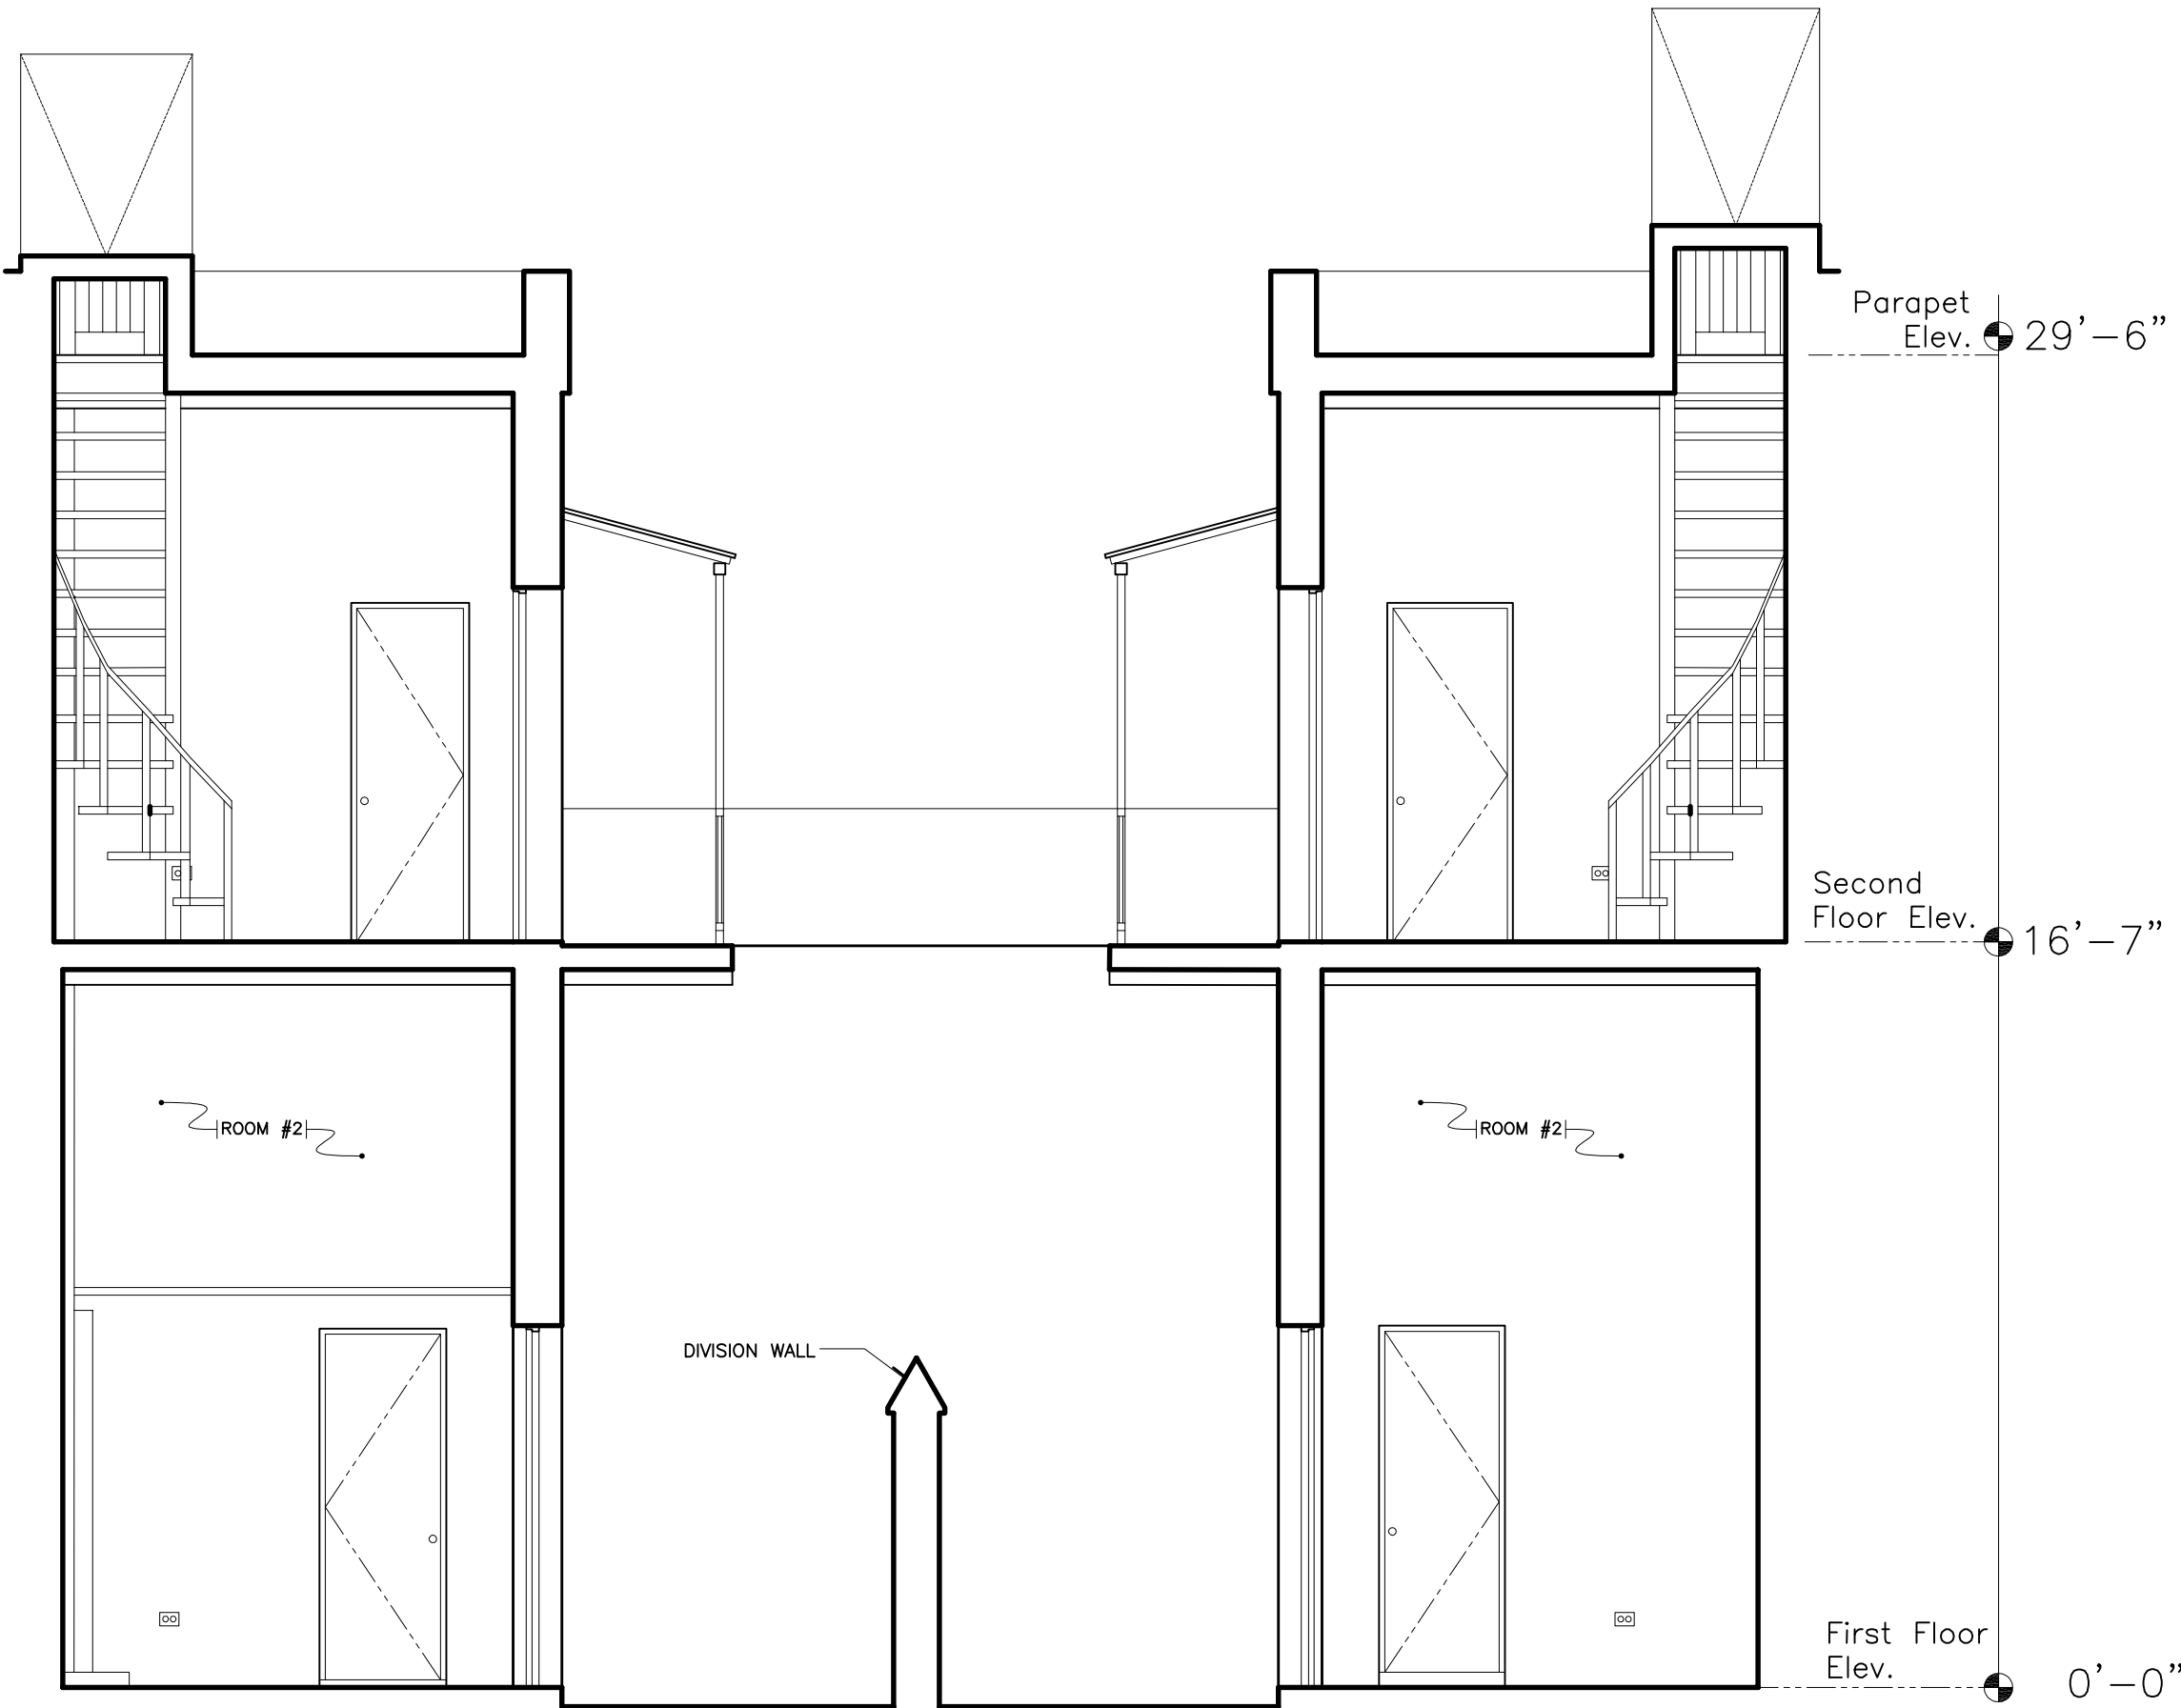

Section A-A

Scale: 1/4"=1'-0"

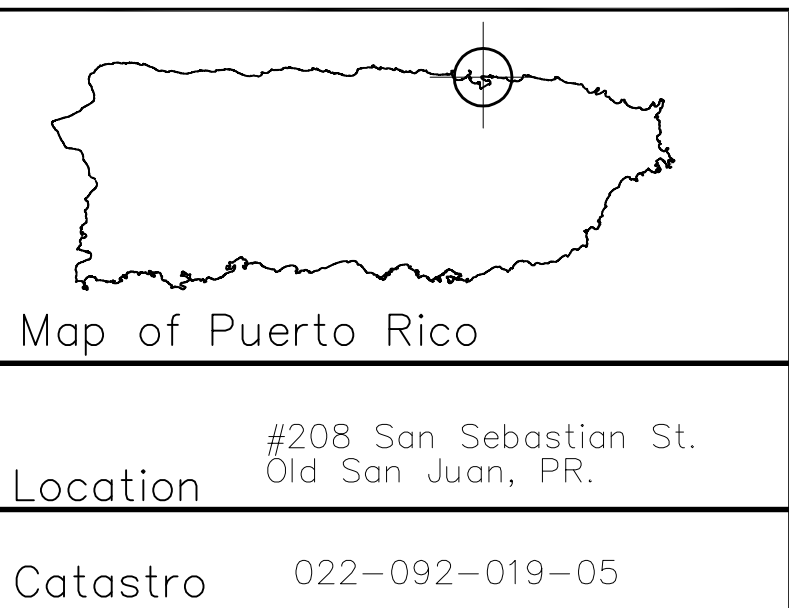

INDEX	
No.	Title
TS-1	TITLE SHEET AND ELEVATION
A-1	EXISTING FIRST FLOOR PLAN AND REFLECTED CEILING
A-2	EXISTING SECOND FLOOR PLAN AND REFLECTED CEILING
A-3	EXISTING ROOF PLAN AND LONGITUDINAL SECTION

#208 San Sebastian St., Old San Juan

As Built Drawings

San Juan, P.R.

LEGEND	
	GENERAL SECTION
	PARTIAL SECTION
	ELEVATION
	NOTE
	FLOOR DRAIN
	DIRECTION OF FLOW
	CHANGE IN FLOOR PATTERN
	110V DOUBLERECEPTACLE
	TELECOMMUNICATIONS OUTLET
	WALL MOUNTED LIGHTFIXTURE
	CEILING MOUNTED LIGHTFIXTURE
	SWITCH
	JUNCTION BOX
	HOSE BIBB
	SMOKE DETECTOR
	ELECTRICAL PANEL

OWNER:

Cherif Medawar

CONSULTANTS

Arq. Radomés Lugo Eschenwald
(787) 594-2873 / ricklugo66@gmail.com

PROJECT:

#208 San Sebastian St., Old San Juan
As Built Drawings

REVISIONS

NO.	DATE
1	
2	
3	
4	
5	


NOTES / PERMITS

DATE: SEPTEMBER 9, 2021


Title Sheet

HOJA:

TS-1

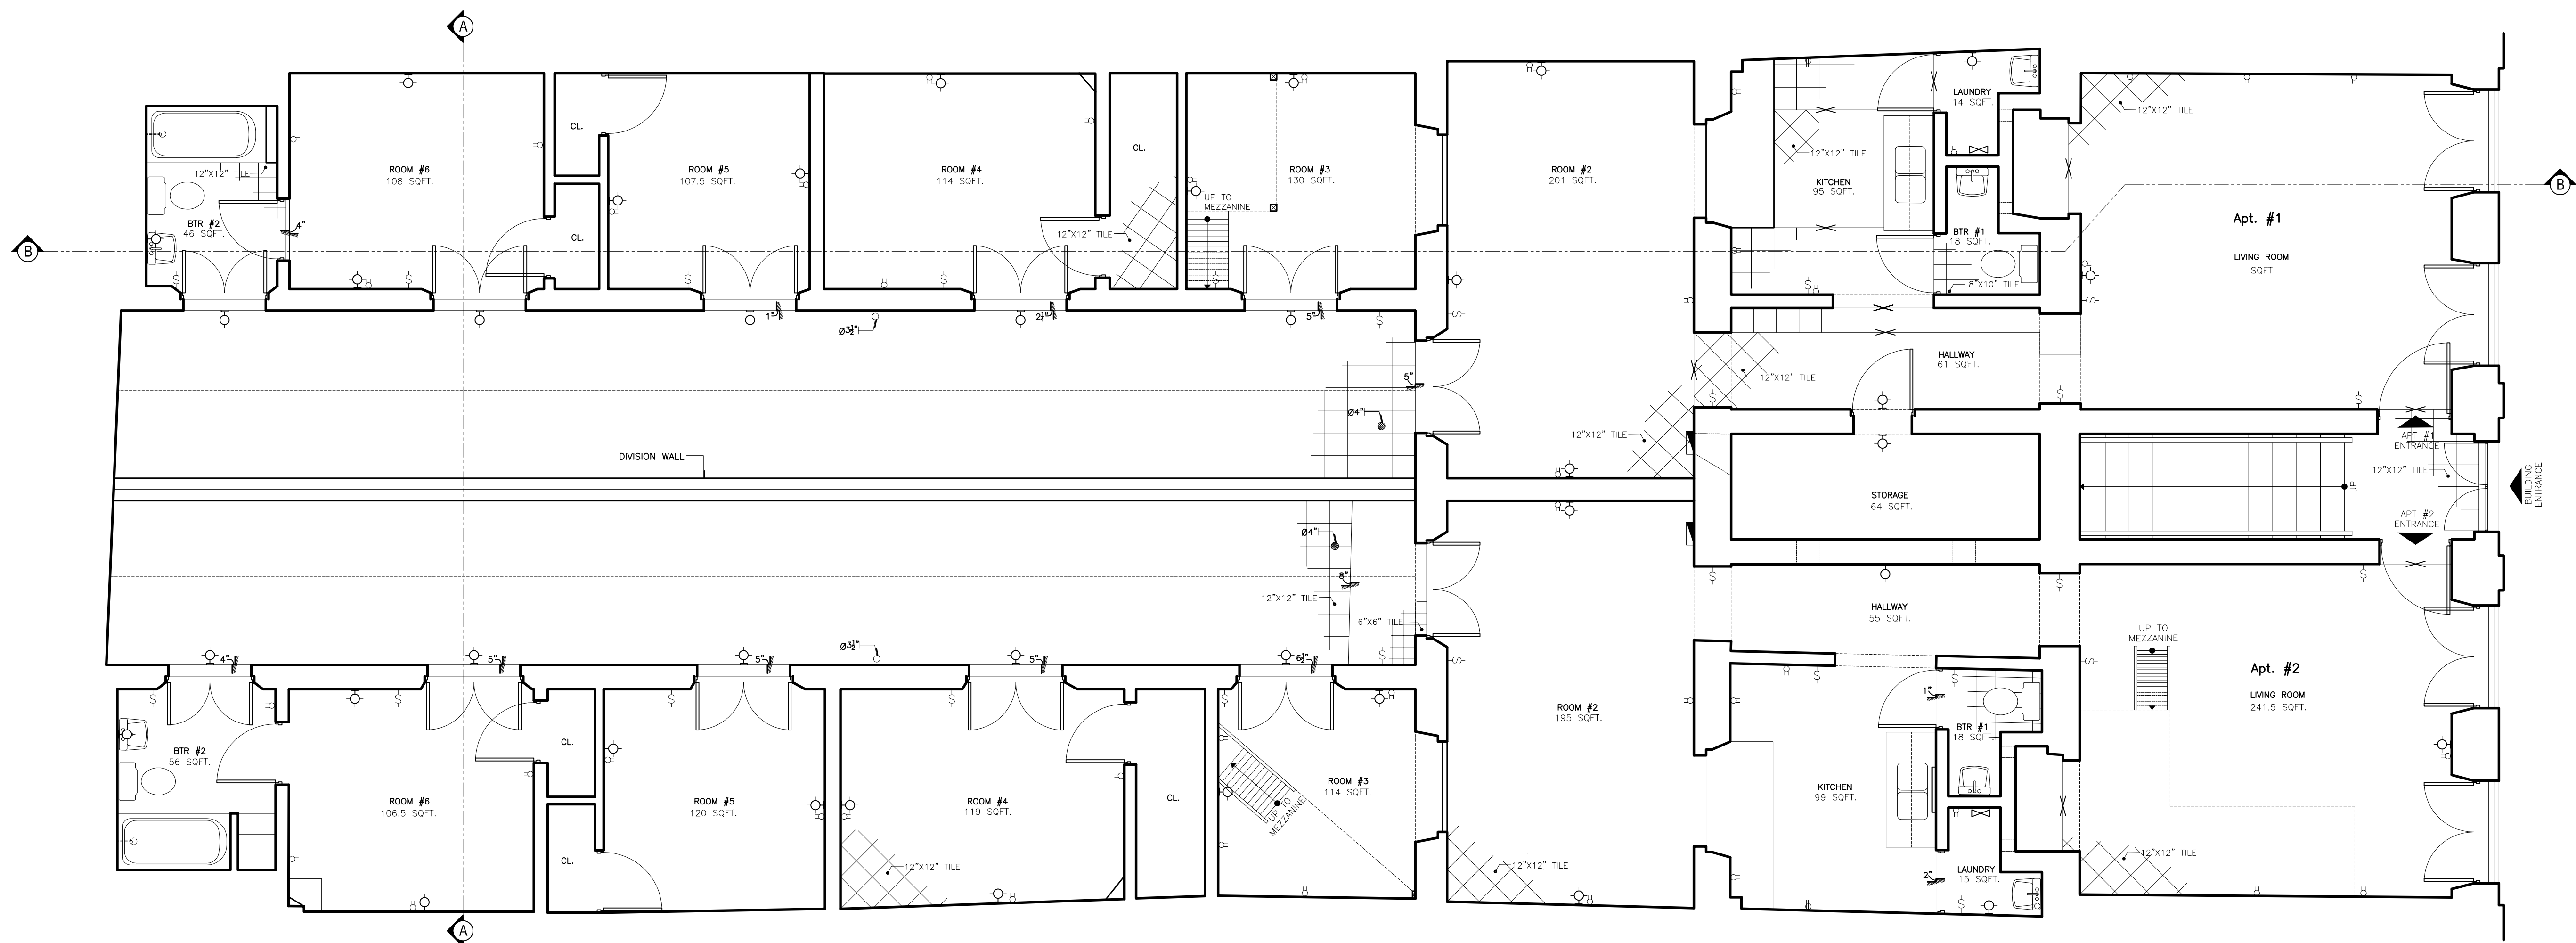

First Floor Plan (Net Area: 3,857 SF)
Scale: 1/4"=1'-0"

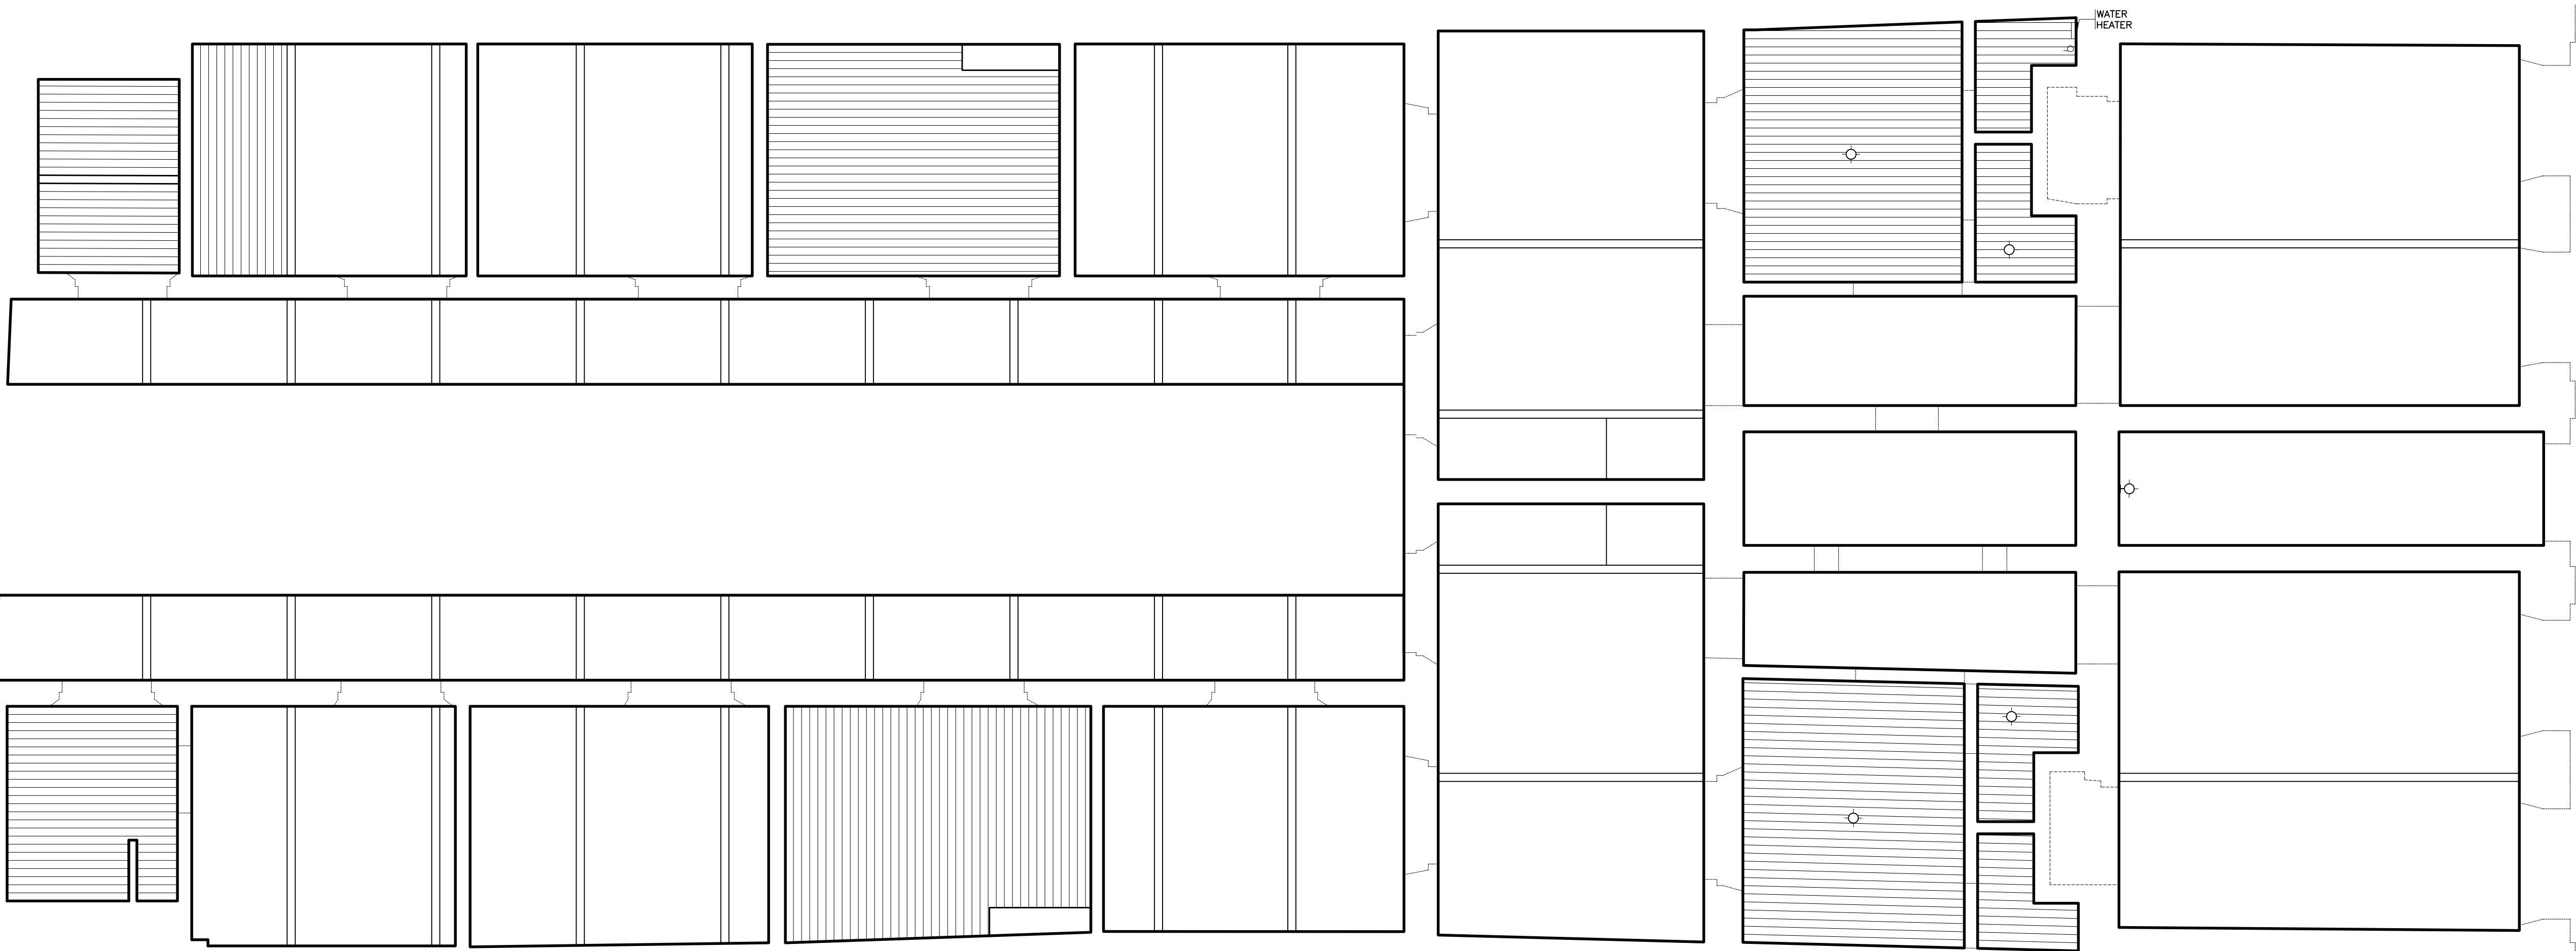

First Floor Plan Reflected Ceiling
Scale: 1/4"=1'-0"

OWNER:
Cherif Medawar

CONSULTANTS
Arq. Radomés Lugo Eschenwald
(797) 504-2873 / ricklugo66@gmail.com


PROJECT:
#208 San Sebastian St., Old San Juan
As Built Drawings

REVISIONS
NO. DATE
1
2
3
4
5


NOTES / PERMITS

DATE: SEPTEMBER 9, 2021
First Floor
Plan & R.
Ceiling
(As Built)


HOJA:
A-1

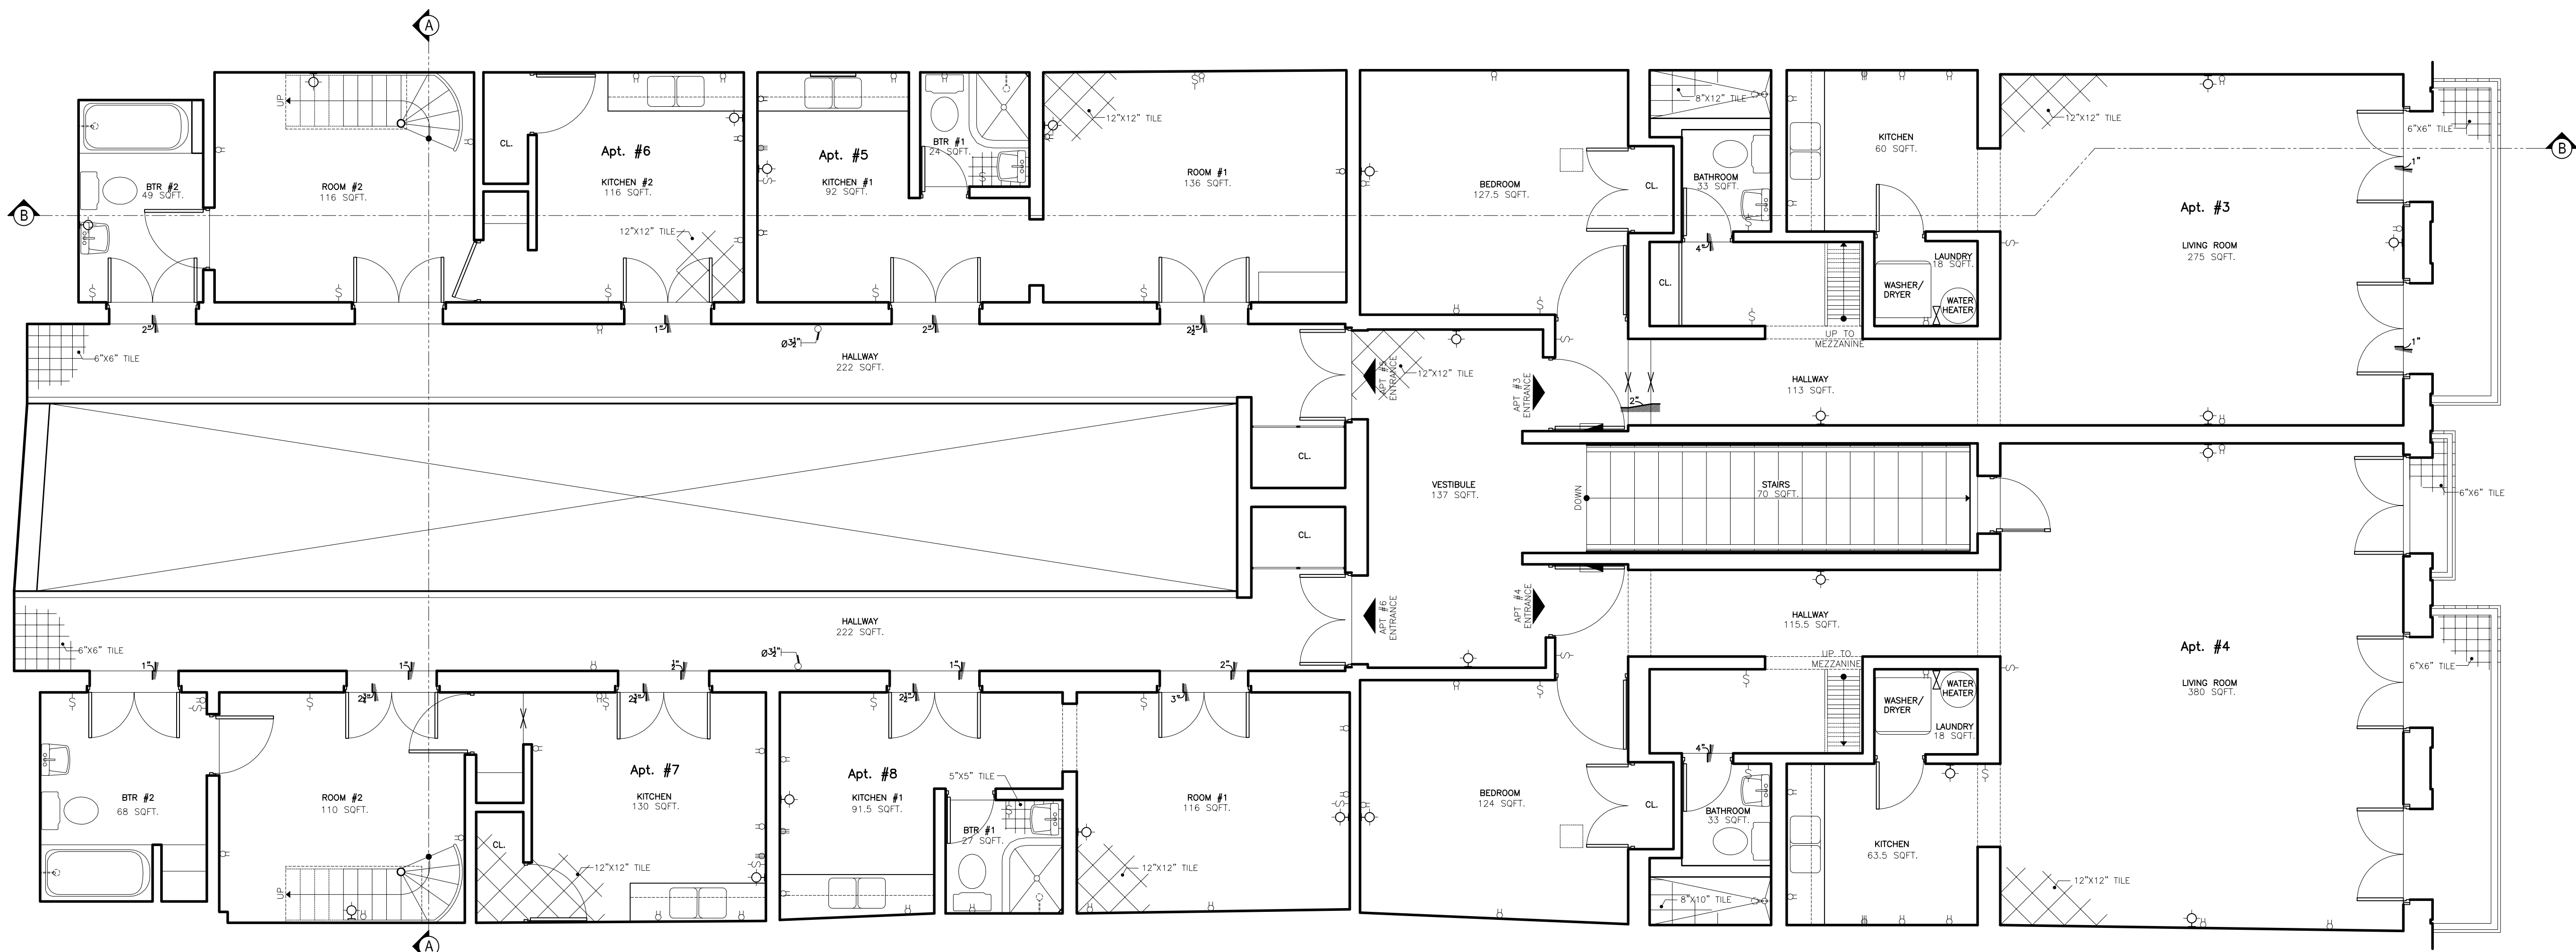


Second Floor Plan (Net Area: 3,581 SF)
Scale: 1/4"=1'-0"

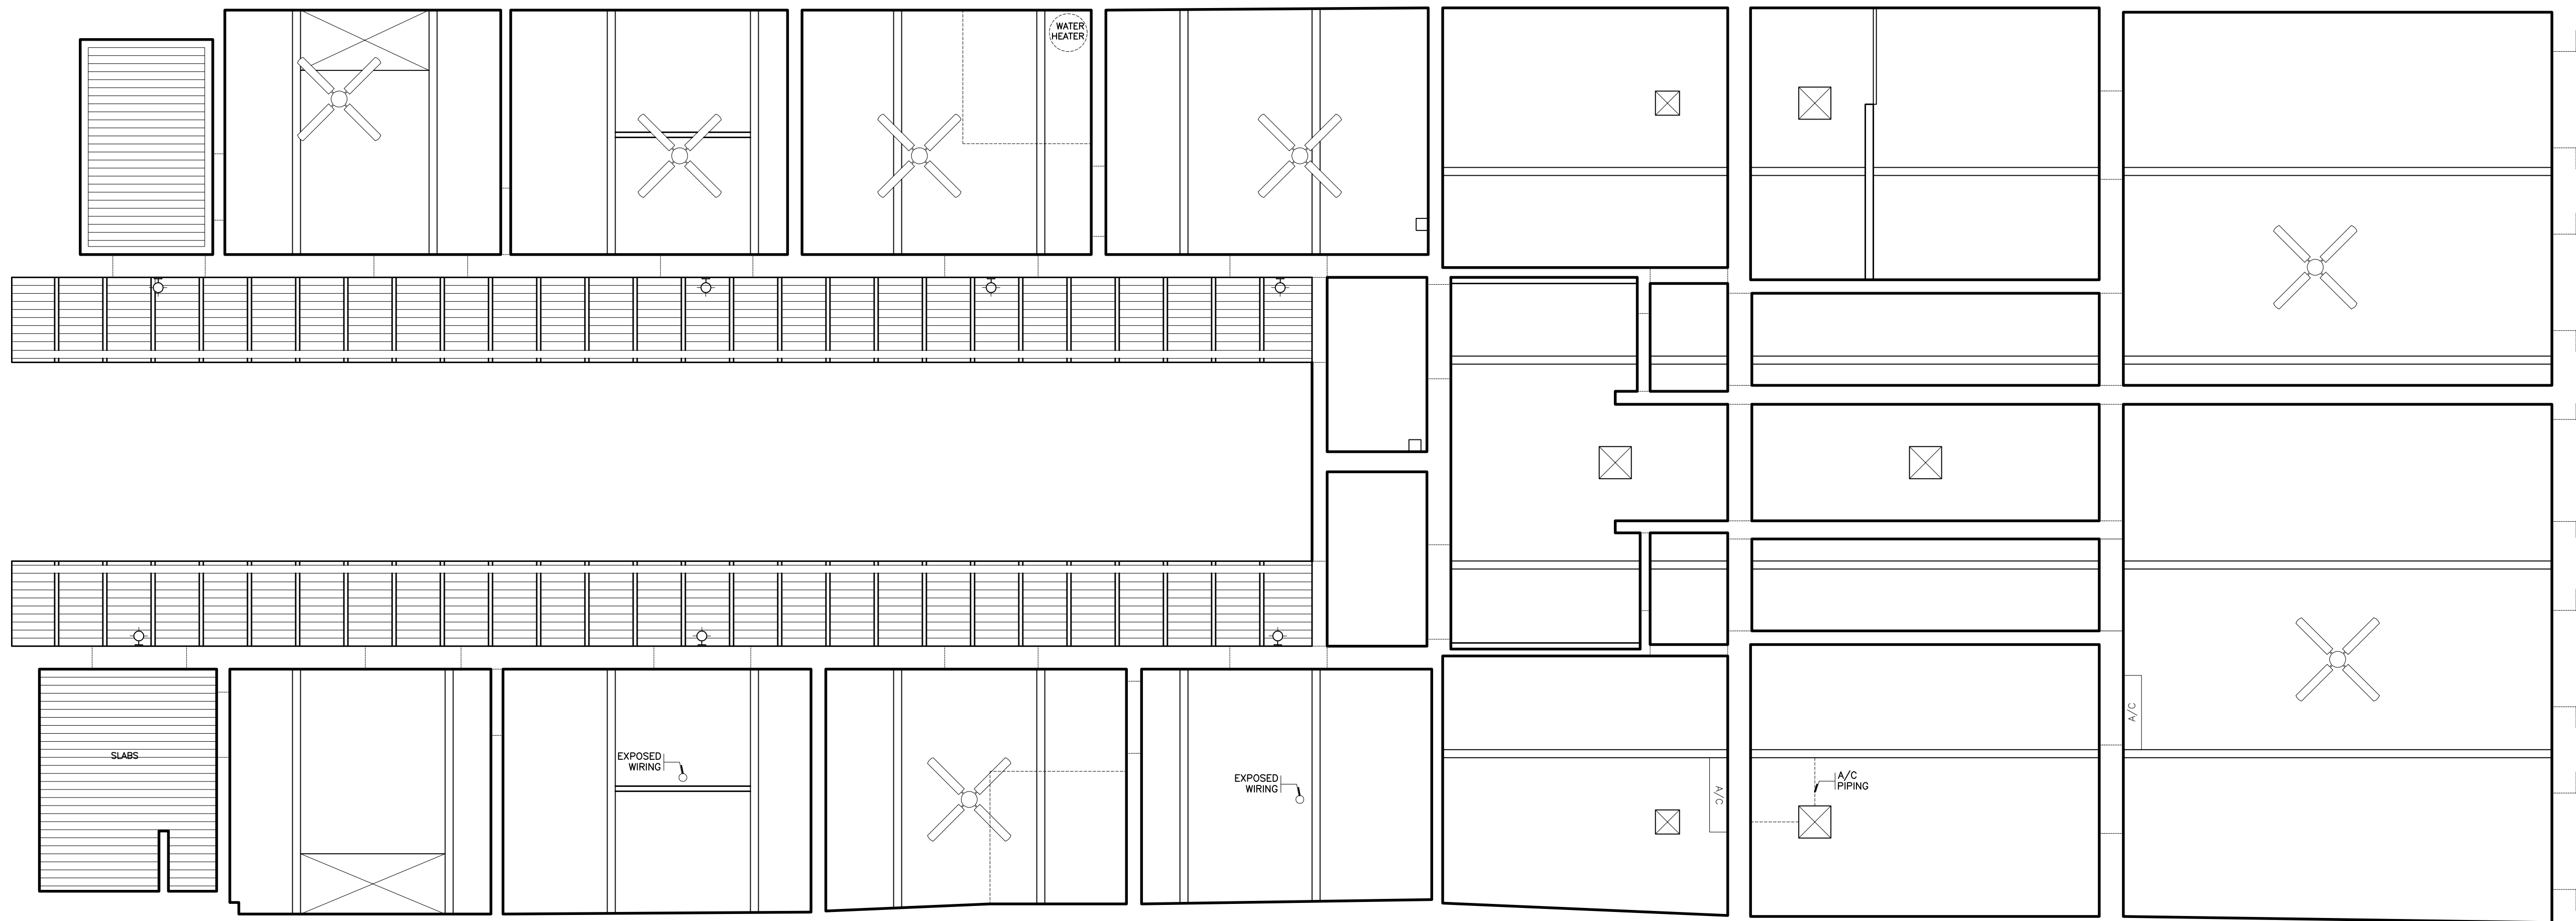

Second Floor Plan Reflected Ceiling
Scale: 1/4"=1'-0"

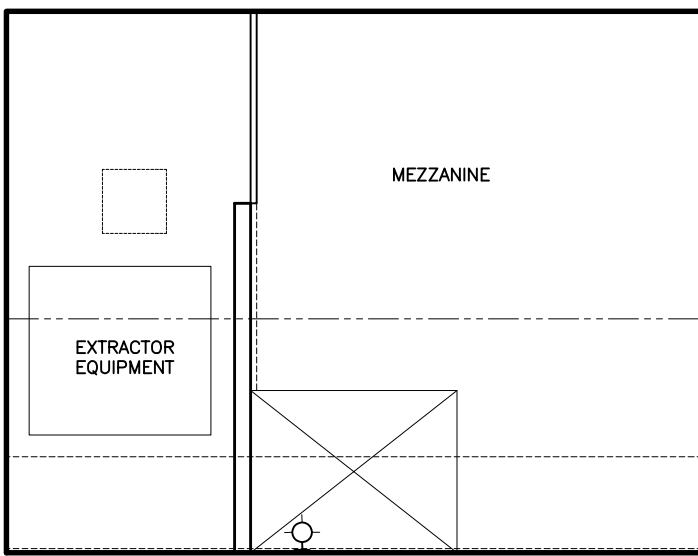


MEZZANINE (APT #3)
Scale: 1/2"=1'-0"

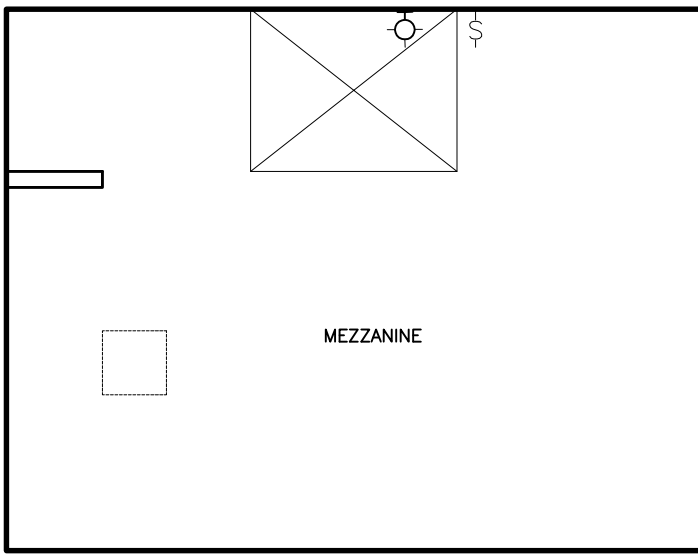

MEZZANINE (APT #4)
Scale: 1/2"=1'-0"

OWNER:		Cherif Medawar	
CONSULTANTS		Arq. Radomés Lugo Eschenwald (797) 594-2293 / ricklugo6@gmail.com	
PROJECT:		#208 San Sebastian St., Old San Juan As Built Drawings	
REVISIONS		DATE: SEPTEMBER 9, 2021	
NO.	DATE	Second Floor Plan & R. Ceiling (As Built)	
1			
2			
3			
4			
5			
NOTES / PERMITS			
HOJA:		A-2	

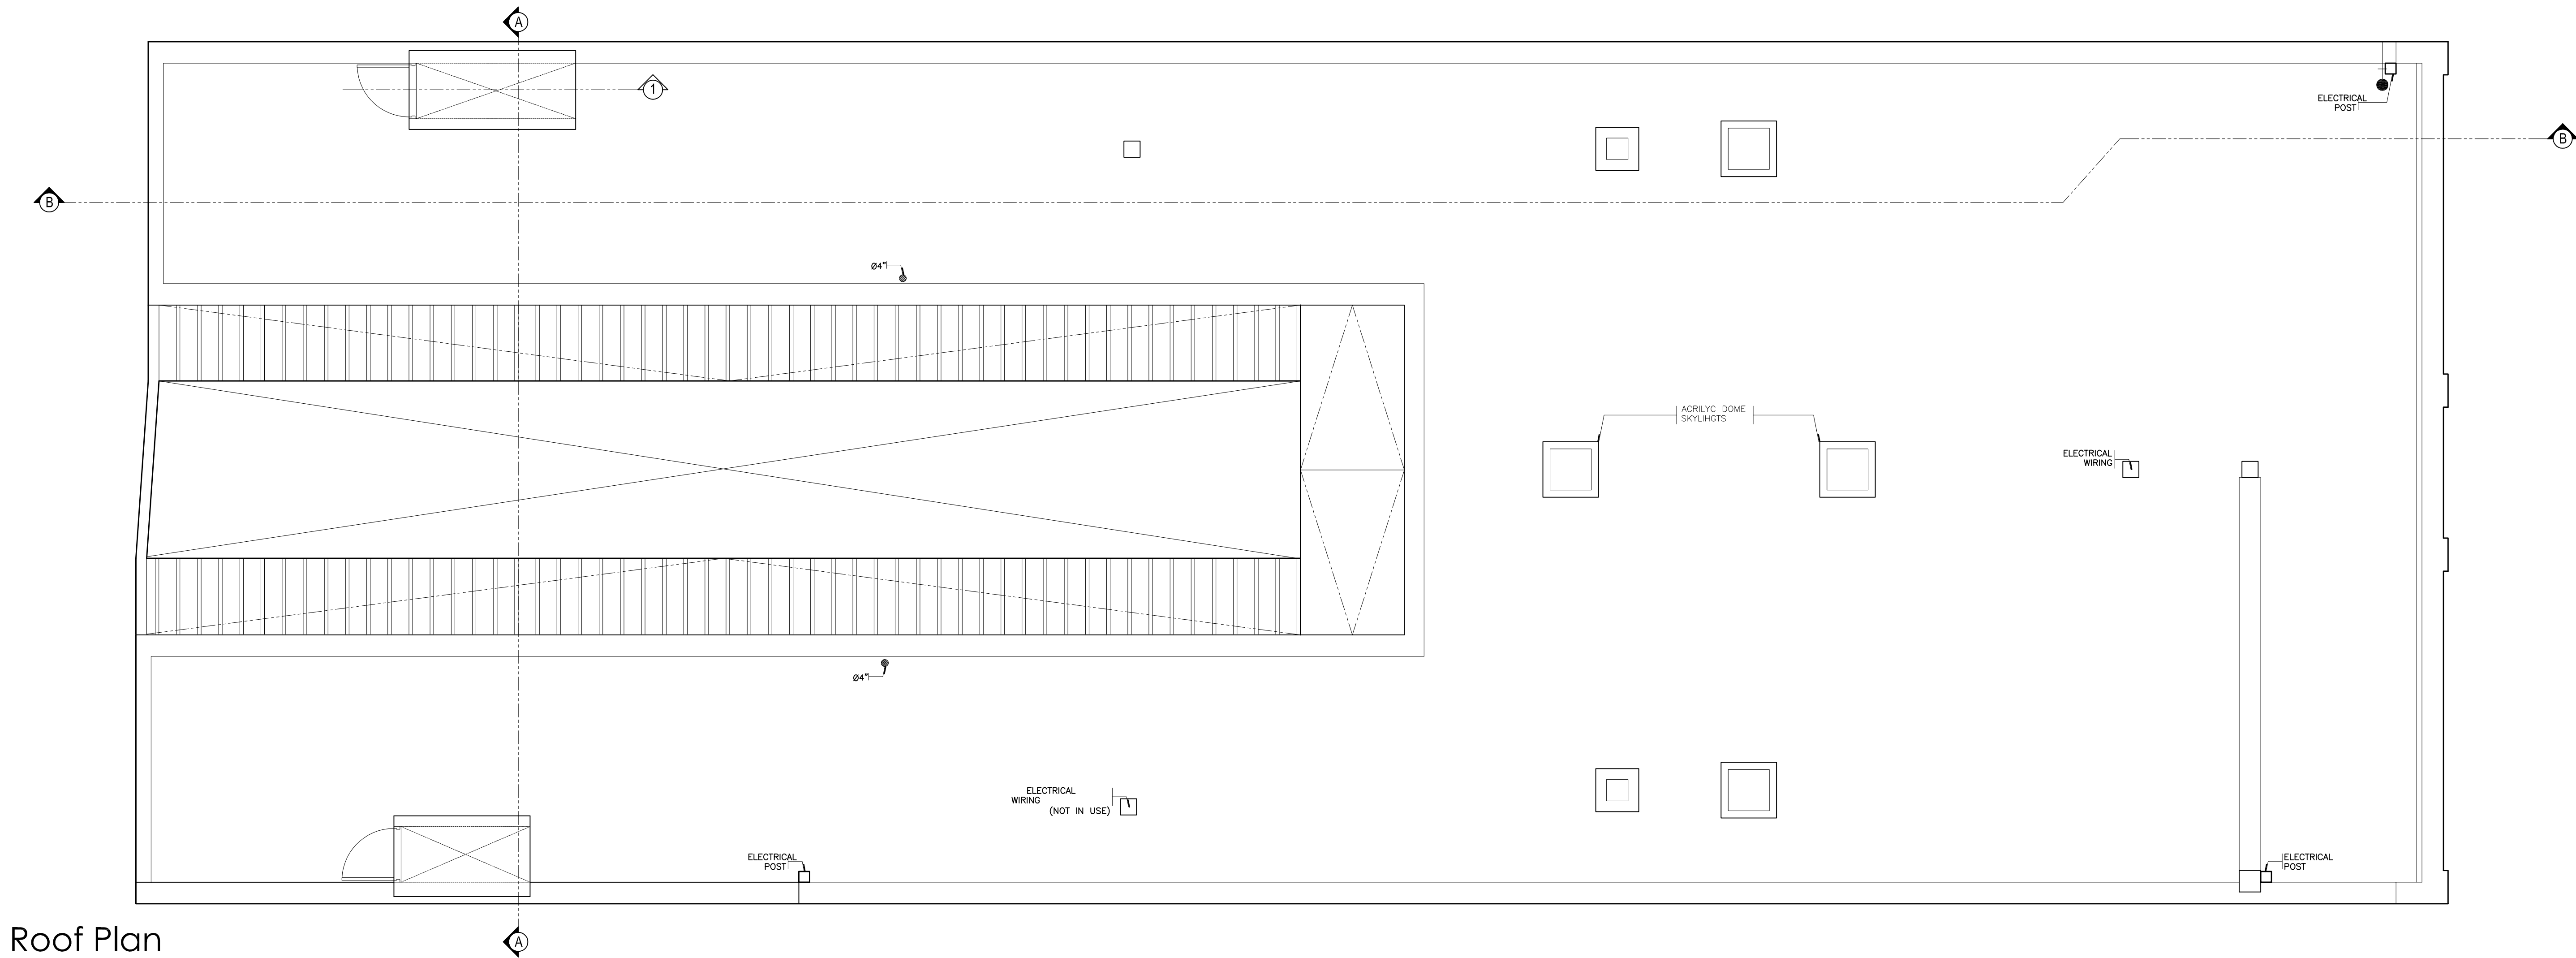

Roof Plan
Scale: 1/4"=1'-0"



Section B-B
Scale: 1/4"=1'-0"

OWNER:	
Cherif Medawar	
CONSULTANTS	
Arq. Radomés Lugo Eschenwald (797) 594-2873 / rlo@eslugo.com	
PROJECT:	
#208 San Sebastian St., Old San Juan As Built Drawings	
REVISIONS	
NO.	DATE
1	
2	
3	
4	
5	
NOTES / PERMITS	
DATE: SEPTEMBER 9, 2021	
Roof Plan & B Section (As Built)	
HOJA:	
A-3	

NIVEL 1,652.80 SQ/FT2

APARTAMENTO DERECHO PR
1709.6 SQ/FT2

92.82 SQ/FT2

PRIMER NIVEL
3,455.22 SQ/FT2

807.60 SQ/FT2

799.97 SQ/FT2

218.45 SQ/FT2

813.33 SQ/FT2

701.97 SQ/FT2

3,341.32 SQ/FT2

SEGUNDO NIVEL

